LAND CORNER RECORDATION CERTIFICATE

Filing Requirement of Act 74, Mich. P.A. 1970

For corners in ARENAC (County)

	Located In:	Corner Code #1
1. Public Land Survey	T 19N R 4E	H-5,H-6,G-6
	T ___ R ___	
	T ___ R ___	
	T ___ R ___	
2. Property Controlling	S 15 T ___ R ___	
in Section	S ___ T ___ R ___	
3. Miscellaneous	S ___ T ___ R ___	
Property in Sec.	S ___ T ___ R ___	

Register of Deeds Stamp & File Number

4. Lot No. _____ , Recorded Plat _____
5. Private Claims _____

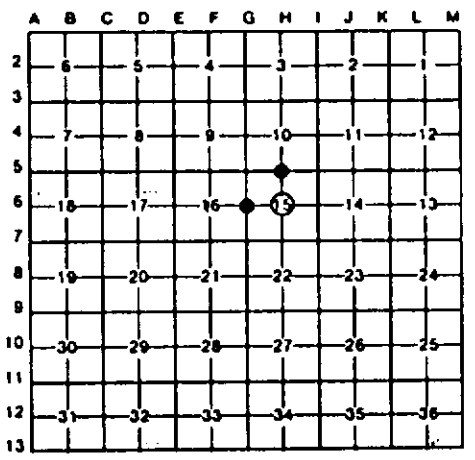

I, CARL KIISKILA , in a field survey on AUGUST 14 , 19 95 , do hereby certify that under requirements of P.A. 74, Michigan P.A. of 1970, the corner points mentioned in lines 1 and 2 above were in conformance with regulations and rules therefore as required in the current manual of survey instructions of the United States Department of the Interior, Bureau of Land Management or by a decree of a Court of Law and/or that the corner points mentioned in lines 3, 4 and 5 above were in conformance with the rules of the Michigan Board of Land Surveyors or by a Decree of a Court of Law; established, re-established, monumented, re-monumented, recovered, found as expressed below:

NOTE: Not more than 4 corners, all in the same town and range, may be recorded on this certificate.

A. Description of original monument and accessories and/or subsequent restoration:

H-5 H-6 G-6

(NO EVIDENCE OF G.L.O. CORNER, B.T'S, LINE TREES & TOPOGRAPHY, AS CALLED OUT IN THE G.L.O. LINE NOTES; UNLESS NOTED IN ITEM "B" BELOW.)

B. Description of corner evidence found and/or method applied in restoring or reestablishing corner:

H-5

FD AND ACCEPTED 1/2" ROD AS SET BY DUANE LEDY P.S, RECORDED PER ACT 74, PA 1970 IN LIBER 1 PAGE 287. THIS CORNER POSITION WAS ALSO USED BY DONALD R. BURGIN P.S, FOR A JAN 1985 CERTIFICATE SURVEY, SEE LIBER 1 PAGE 528. CTR OF E-W GRAVEL RD IS 40' S.

H-6

FD AND ACCEPTED 1/2" BAR FOR THE CTR OF SEC 15 AS SET BY DUANE LEDY P.S, RECORDED PER ACT 74, PA 1970 IN LIBER 1, PAGE 287. CORNER FITS CALC. POSITION PER STD BLM INSTRUCTIONS FOR SUB'D OF A SECTION. CTR E-W GRAVEL RD IS 38' SOUTH.

G-6

FD AND ACCEPTED 1/2" ROD AS SET BY TIM LABHAM P.S, FOR THE W 1/4 COR SEC 15. THIS COR WAS RECORDED PER ACT 74, PA 1970 BY TIM LABHAM P.S, IN LIBER 1 PAGE 264 DATED JAN 3, 1986. CTR N-S GRAVEL RD IS 30' EAST.

C. Description of monument for corner and accessories established to perpetuate locating the position of the corner:

H-5

FD 1/2" BAR W/CAP (LEDY)

#14" OAK	S57°E	12.35'
#8" OAK	S07°W	20.48'
#6" OAK	N86°W	34.95'
18" OAK	N21°E	30.89'

#LEDY WIT. 1989 LI 1, PG 287.

H-6

FD 1/2" BAR W/CAP (LEDY)

#12" OAK	S61°E	17.07'
#5" OAK	S76°W	4.57'
#14" OAK	N68°E	33.53'
POWER POLE	N45°E	45.05'

#LEDY WITNESS LI 1, PG 287.

G-6

FD 1/2" CAPPED IRON.

#POWER POLE	N45 W	13.55'
#2" PIPELINE MARKER (CTR)		
	N80°W	40.64'
#11" OAK	S42°W	57.11'
14" OAK	N54°E	77.23'

#T. LAPHAM WIT. LI 1, PG 264.

STATE OF MICHIGAN
CARL KIISKILA
LAND SURVEYOR
No. 33981
LICENSED LAND SURVEYOR

Signed by Carl T Kiiskila Date 9-6-95

Surveyor's Michigan License No. 33981

FORM APPROVED BY MICHIGAN STATE BOARD OF LAND SURVEYORS, JAN. 26, 1971
REVISED MAY 14, 1975
REVISED JAN., 1983