

LAND CORNER RECORDATION CERTIFICATE


Filing Requirement of Act 74, Mich. PA 1970

For Corners In: <u>Arenac</u> (County)	Located In	Corner Code #
1. Public Land Survey	T <u>19N</u> R <u>4E</u>	<u>I-5</u>
2. Property Controlling in Section	S _____ T _____ R _____	_____
3. Miscellaneous Property in Section	S _____ T _____ R _____	_____
4. Lot No: _____	Recorded Plat: _____	
5. Private Claims: _____		

Register of Deeds Stamp & File Number

I, Craig W. McVean, in a field survey on April 19, 2000 do hereby state that under requirements of PA 74, Michigan PA of 1970, the corner points mentioned in lines 1 and 2 above were in conformance with regulations and rules therefore as required in the current manual of survey instructions of the United States Department of the Interior, Bureau of Land Management or by a decree of a Court of Law and/or that the corner points mentioned in lines 3, 4 and 5 above were in conformance with the rules of the Michigan Board of Land Surveyors or by a Decree of a Court of Law; established, re-established, monumented, recovered, found as expressed below:

NOTE: Not more than 2 corners, all in the same town and range, may be recorded on this certificate.

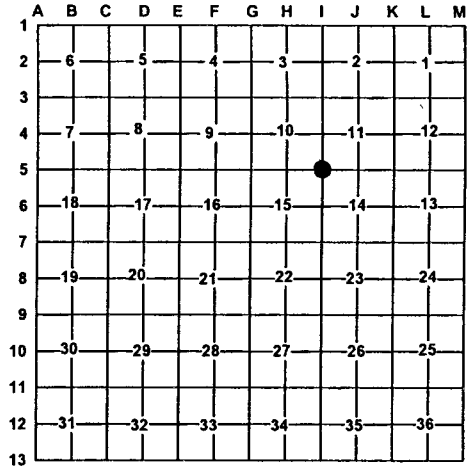

- A. Description of original monument and accessories and/or subsequent restoration:**
- | | |
|--|---|
| <p><u>I-5</u> – GLO – Set post – J. Burt – 1843
 Spruce 11" S52°E 23 L.
 Spruce 14" N23°E 30 L.
 - Rec. Sur. L. 1, P.528 – D. Burgin – 1985
 Set 'T' iron w/ cap at base of broken fence post.
 South 41' to CL. Stewart Rd.
 S30°E 5.79' to nail in 10" Pine
 S75°E 15.85' to nail in 12" Pine
 N25°E 17.82' to nail in 8" Pine</p> | <p>- LCRC - L.1, P. 264 – T.L. Lapham – 1985
 Fd. RLS capped iron – S40°E 5.76'- 10" J. Pine;
 East 15.85- 16" J. Pine; N 15°E 17.80'- 8" J. Pine
 S5°W 59.08'- 18" Oak
 - Rec. Sur. L.1, P.537 – T.L. Lapham - 1985
 L.1, P.545 & 547 – T.L. Lapham – 1986
 - LCRC – L. 2, P. 51 – C. Kiiskila - 1995
 Fd. 1" 'T' iron per D. Burgin & used by T. Lapham &
 D. Ledy. Placed DNR Mon. over 'T' iron & set carsonite post.
 10" J. Pine S40°E 5.77'
 16" J. Pine E 15.81'; 8" J. Pine
 N15°E 17.78'; 18" Oak S5°W 59.05'</p> |
|--|---|

B. Description of corner evidence found and/or method applies in restoring or re-establishing corner:
I-5 – Sec. corner common to Sec. 10, 11, 14 & 15 – Fd. 4" DNR alum. Cap on 1" iron pipe per Kiiskila. CL. of E-W Gravel Rd. is 38'+ S. Recent power line construction has removed most record BT's. Mon. in line w/ old fence line North. DNR Mon. accepted as the best available evidence of the position of the original corner.

C. Description of monument for corner and accessories established to perpetuate locating the position of the corner:
I-5 – 4" DNR alum. Cap on 1" galv. Iron pipe.
 Set Blue Carsonite Post 1' S
 N20°E 17.85' to set N & T in E side 10" J. Pine scribed 'XBT' (DB, TL, CK)
 N21°W 31.51' to set N & T in E side 11" J. Pine scribed 'XBT'
 S76°W 67.91' to set N & T in N side 7" Oak scribed 'XBT'
 S5°W 12.34' to set N & T in E side PP stub.



Signed by: Craig W. McVean
 Surveyor's Michigan License No.: 39088

Date: 12/13/2001