

LAND CORNER RECORDATION CERTIFICATE

Filing Requirement of Act 74, Mich. PA 1970

For Corners In: Arenac _____ (County)	Located In	Corner Code #
1. Public Land Survey	T <u>19N</u> R <u>4E</u>	<u>J5</u>
	T _____ R _____	_____
2. Property Controlling in Section	S _____ T _____ R _____	_____
	S _____ T _____ R _____	_____
3. Miscellaneous Property in Section	S _____ T _____ R _____	_____
	S _____ T _____ R _____	_____


Register of Deeds Stamp & File Number

4. Lot No: _____ Recorded Plat: _____

5. Private Claims: _____

I, Craig W. McVean, in a field survey on October 26, 2000 do hereby state that under requirements of PA 74, Michigan PA of 1970, the corner points mentioned in lines 1 and 2 above were in conformance with regulations and rules therefore as required in the current manual of survey instructions of the United States Department of the Interior, Bureau of Land Management or by a decree of a Court of Law and/or that the corner points mentioned in lines 3, 4 and 5 above were in conformance with the rules of the Michigan Board of Land Surveyors or by a Decree of a Court of Law; established, re-established, monumented, recovered, found as expressed below:

NOTE: Not more than 2 corners, all in the same town and range, may be recorded on this certificate.

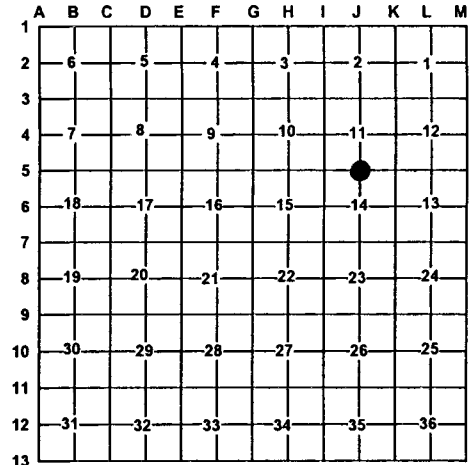

A. Description of original monument and accessories and/or subsequent restoration:

- | | |
|--|--|
| <p><u>J-5</u> – GLO – Set ¼ post – J. Burt – 1843
 W. Oak 16" S29°E 1 L.
 W. Oak 6" N80°W 8 L.
 - Rec. Sur. L.2., Pg. 99 – 1995 – T. Lapham
 Fd. capped iron, S. 15' to C/L of Steward Rd.
 N70°W 70.39'- 18" Oak; N19°E 62.72'- 20" Oak;
 S21°E 49.90' fence cor. ; S54°W 73.85'- 30" Oak</p> | <p>- LCRC L.2, Pg. 49 – C. Kiiskila – 1995
 Fd. ½" capped rod set by Tim Lapham midway & on line between Fd. Sec. corners ½ mile E&W. Ctr. of Trail Rd. NW is 12' W.
 Set 1" X 32" pipe with Alum. cap over Lapham iron.
 16" Oak N64°W 70.37' 21" Oak N20°E 62.64'
 10" Oak S22°W 57.36' Fn. post S26°E 49.92'
 Ctr. of E-W Rd. S. 18' +/- Set Carsonite post N 16.5'</p> |
|--|--|

B. Description of corner evidence found and/or method applies in restoring or re-establishing corner:

J-5 – ¼ Corner common to Sec. 11 & 14 – Fd. 4" DNR Alum. cap on 1" pipe – down 0.3' – per LCRC. on N. edge of gravel Rd. DNR Mon. accepted as a careful & faithful reestablishment of the position of the original corner.

C. Description of monument for corner and accessories established to perpetuate locating the position of the corner:

J-5 – DNR Mon. Added tin can w/ conc. around 4" Alum. cap.
 Set blue carsonite post 33' N.
 N72°W 70.31' to Fd. nail in N side 20" Oak (TL,CK)
 N16°E 62.58' to Fd. nail in W. side 27" Oak (TL,CK)
 S29°E 49.91' to Fd. nail in SW side 6" wood fence post (TL,CK)
 S22°W 57.37' to Fd. nail in E side 11" Oak
 N77°E 138.70' to set N&T in N. side 14" R. Pine scribed 'XBT'



Signed by: Craig W. McVean
 Surveyor's Michigan License No.: 39088

Date: 12/13/2001