

LAND CORNER RECORDATION CERTIFICATE

Filing Requirement of Act 74, Mich. PA 1970

For Corners In:
Arenac Located In _____ Corner Code # _____
 (County)

1. Public Land Survey T 19N R 4E K7
 T _____ R _____
 2. Property Controlling in Section S _____ T _____ R _____
 S _____ T _____ R _____
 3. Miscellaneous Property in Section S _____ T _____ R _____
 S _____ T _____ R _____


4. Lot No: _____ Recorded Plat: _____

5. Private Claims: _____

I, Craig W. McVean, in a field survey on October 4, 2001 do hereby state that under requirements of PA 74, Michigan PA of 1970, the corner points mentioned in lines 1 and 2 above were in conformance with regulations and rules therefore as required in the current manual of survey instructions of the United States Department of the Interior, Bureau of Land Management or by a decree of a Court of Law and/or that the corner points mentioned in lines 3, 4 and 5 above were in conformance with the rules of the Michigan Board of Land Surveyors or by a Decree of a Court of Law; established, re-established, monumented, recovered, found as expressed below:

NOTE: Not more than 2 corners, all in the same town and range, may be recorded on this certificate.

Register of Deeds Stamp & File Number

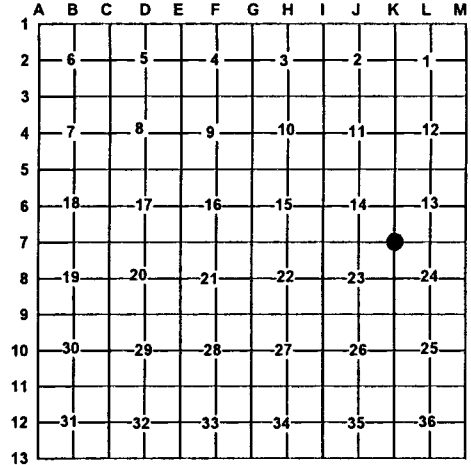

A. Description of original monument and accessories and/or subsequent restoration:

- K7-GLO-set post-J. Burt-1843
 - W. Pine 16" N60°E 15 links
 - W. Pine 8" S47.5°W 3 links
 - CSR-Fb. 8; p. 45-1909- a Cedar post. W. Pine st. 22" N55°W 20; W. Pine st. 15" S52.5°W 23 – Rd. Survey
 - MDOT-1957- dug hole 6' X 4' X 3'. Set 1/2" X 2" iron midway between N & S fences and on E-W fence line.-corner fence post West 30'; fence post N41°E 42.98'; Fence post N81°E 29.90'
 - LCRC L.1, P.131 and recorded survey L.1, P.374- J.W. Sedgeman- 1979- Found 1/2" X 1 1/2" strap iron; S85°W 47.90'-P. Pole; N15°W 73.10'- 12" apple; N20°E166.52'- 8" apple
 - LCRC- L. 2, P. 50- C. Kiiskila- 1995- Found 3/4" X 2" strap iron in centerline of N-S road. P. Pole N85°W 47.11'; P. Pole N65°E 56.98'; Apple tree N18°E 164.68'; Phone Riser box S86°E 27.09'

B. Description of corner evidence found and/or method applies in restoring or re-establishing corner:

- K7-Section corner common to section 13, 14, 23 and 24- Found 3/4" X 2" X 1.6' long upright old iron wrench per MDOT and LCRC's in centerline of N-S gravel Rd. in line E-W field lines. Iron wrench accepted as the best available evidence of the position of the original corner.

C. Description of monument for corner and accessories established to perpetuate locating the position of the corner:

- K-7 -Replaced iron wrench with 3" Arenac Co. Remon. brass cap on 5/8" X 32" rebar with tin can and concrete around cap -Down 0.5' N60°E 56.93' to found MDOT tag in NW side of UP (CK)
 S82°W 28.86' to set nail and tag in North side of UP (CK)
 N12°E 164.62' to found nail in west side 12" Apple (JWS, CK)
 N48°W 128.44' to southwest corner of Blk. Fndt . HSE. #1515



Signed by: Craig W. McVean
 Surveyor's Michigan License No.: 39088

Date: 12/13/2001