


LAND CORNER RECORDATION CERTIFICATE


Filing Requirement of Act 74, Mich. PA 1970

For Corners In:			
Arenac	Located In	Corner Code #	
(County)			
1. Public Land Survey	T <u>19N</u> R <u>4E</u>	<u>L3</u>	
	T _____ R _____	_____	_____
2. Property Controlling in Section	S _____ T _____ R _____	_____	_____
	S _____ T _____ R _____	_____	_____
3. Miscellaneous Property in Section	S _____ T _____ R _____	_____	_____
	S _____ T _____ R _____	_____	_____
4. Lot No: _____	Recorded Plat: _____		
5. Private Claims: _____			

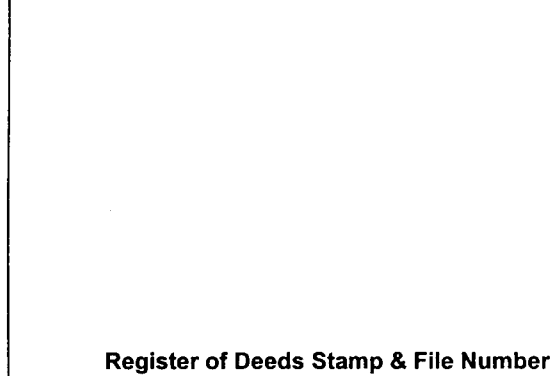

I, Craig W. McVean, in a field survey on October 25, 2000 do hereby state that under requirements of PA 74, Michigan PA of 1970, the corner points mentioned in lines 1 and 2 above were in conformance with regulations and rules therefore as required in the current manual of survey instructions of the United States Department of the Interior, Bureau of Land Management or by a decree of a Court of Law and/or that the corner points mentioned in lines 3, 4 and 5 above were in conformance with the rules of the Michigan Board of Land Surveyors or by a Decree of a Court of Law; established, re-established, monumented, recovered, found as expressed below:

NOTE: Not more than 2 corners, all in the same town and range, may be recorded on this certificate.

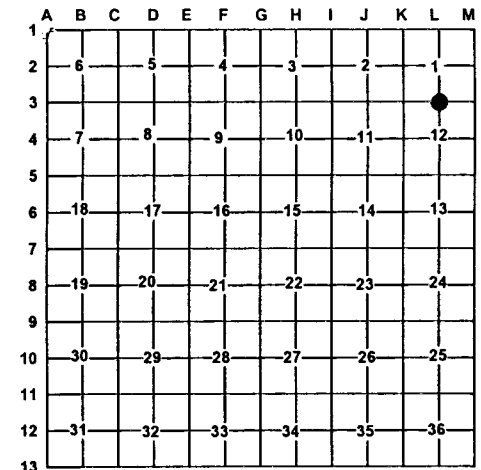

- A. Description of original monument and accessories and/or subsequent restoration:
- L3 - GLO - Set 1/4 post - J. Burt - 1843
 - S. Pine 10" N55°E 25 L.
 - Y. Pine 22" S82°W 30 L.
 - CSR - Lg. Bk., P. 37 - G.F. Carscallen - 1900
 - Sec. 12 Survey. One Witness found.
 - CSR - FB. 1, P.34- 1910 - Fd. ogl. Wit. & old rotten oak post
 - B. Oak 10" N47°E 66 L.
 - B. Oak 8" N54 1/2°W 55 L.
 - MDOT - 1957 - Fd. 4" x 4" wood stake
 - Set 1" axle, 8" Oak N75°W 18.64'; 12" Oak N5°E 14.82';
 - 9" Oak S50°E 12.25'
 - Rec. Sur. - L.2, P.133 & 150 - Fd. 1" axle shaft - 1996

B. Description of corner evidence found and/or method applies in restoring or re-establishing corner:

L3 - 1/4 corner common to Sec. 1 & 12 - Fd. 1" x 2.4" axle shaft per MDOT notes & Rec. Survey leaning - we straighten. Centerline of E-W Sand Rd. is 55' S. Fit Co. Survey distance E & W proportionally being 6'+/- longer than Co. record of 1910. GLO & CSR BT's are gone. Appears that MDOT recovered perpetuated original corner position. 1" axle accepted as a careful & faithful perpetuation of the position of the original corner.

C. Description of monument for corner and accessories established to perpetuate locating the position of the corner:

L3 - Replaced 1" x 2.4' axle shaft with 4" DOC (DNR) alum. cap on 1" x 4' Galv. Iron pipe. Set Blue Carsonite Post 1' NE
 Reset steel fence post 1' W
 S59°E 12.52' to set N & T in S side 24" Oak scribed 'XBT' (MDOT)
 S81°W 10.76' to set N & T in S side 7" Oak scribed 'XBT'
 N58°E 66.69' to set N & T in SE side 15" W. Pine scribed 'XBT'
 N8°E 16.08' to set N & T in W side 5" Oak



Signed by: Craig W. McVean
 Surveyor's Michigan License No.: 39088

Date: 12/13/2001