

LAND CORNER RECORDATION CERTIFICATE

FILING REQUIREMENT OF ACT 74, MICH. P.A. 1970

FOR CORNERS OF--	LOCATED IN--	CORNER CODE NUMBER
1. PUBLIC LAND SURVEY.....	T. 19 N. R. 5 E. 1	C-2; C-3; C-4
2. PROPERTY CONTROLLING IN SECTION 5	T. 19 N. R. 5 E. 1	1
3. MISCELLANEOUS PROPERTY IN SECTION.....	T. S. R. W.	
4. LOT NO. _____, RECORDED PLAT.....		
5. PRIVATE CLAIMS.....		

REGISTER OF DEEDS STAMP AND
FILING NUMBER _____

I, Kenneth J. Ostling, do hereby certify that under requirements of P.A. 74, Michigan P.A. of 1970, the corner points mentioned in lines 1 and 2 above were, in a field survey on September 17, 1979, established, re-established, monumented, re-monumented, recovered or restored as expressed below and in conformance with regulations and rules therefore as required in the current manual of survey instructions of the United States Department of the Interior, Bureau of Land Management or by a decree of a court of law. Furthermore, that the corner points mentioned in lines 3, 4 and 5 above were, in a field survey on _____, 19____ found, recovered, restored, established or re-established as expressed below and in conformance with the rules of the Michigan State Board of Registration for Land Surveyors or, by a Decree of a Court of law:

~~A. Description of original monument and accessories and/or subsequent restoration:~~
C. (continued)

1
Set 5/8" Rod w/RLS Cap
9" Oak S57°W 11.03
4" Oak S08°E 18.61

B. Description of corner evidence found and/or method applied in restoring or re-establishing corner:

- 2 Set corner by proportionate measurement between section corners, which fits G. H. Hollister 1910 survey of record measurements and conforms acceptably to river crossings, etc.
- 5 Set corner in center of N-S road, in line with old fence west, which we conclude conforms to G. H. Hollister survey record in Section 8.
- 1 Found 1 1/2" iron bar at road intersection which we conclude to be properly located, probably during G. H. Hollister survey of Section 8.
- 1 Set corner by standard survey procedure for the subdivision of sections. Set to mark State boundary.


C. Description of monument for corner and accessories established to perpetuate locating the position of the corner:

C-2	C-3	C-4
Set DNR Monument	Set DNR Monument	1 1/2" Iron Bar in Place
14" Maple N67°W 23.15	10" Cedar N86°E 19.54	15" Oak N71°E 28.5
7" Maple N36°E 36.5	12" Cedar S12°E 54.23	4" W. Pine S39°E 55.21

SIGNED BY Kenneth J. Ostling

DATE 10/1/79

SURVEYOR'S MICHIGAN REGISTRATION NO. 10068

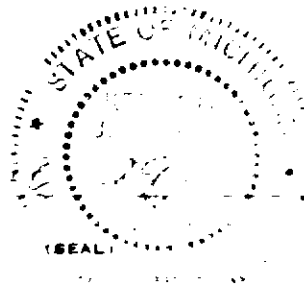

FOR STATE AND UNITED STATES AGENCIES:

SIGNED BY _____ DATE _____
CHIEF OF SURVEY PARTY

APPROVED AND SIGNED BY _____ DATE _____
MICHIGAN REGISTERED LAND SURVEYOR

SURVEYOR'S MICHIGAN REGISTRATION NO. _____

ARENAC COUNTY