

LAND CORNER RECORDATION CERTIFICATE
Filing Requirement of Act 74, Mich. P.A. 1970

For corners in
ARENAC
 (County)

Located In: _____ Corner Code #

- | | | | | | |
|------------------------------------|---|------------|---|-----------|----------------------------------|
| 1. Public Land Survey | T | <u>19N</u> | R | <u>6E</u> | <u>6-12</u> |
| | T | _____ | R | _____ | _____ |
| | T | _____ | R | _____ | _____ |
| | T | _____ | R | _____ | _____ |
| 2. Property Controlling in Section | S | _____ | T | _____ | _____ |
| | S | _____ | T | _____ | _____ |
| 3. Miscellaneous Property in Sec. | S | <u>33</u> | T | _____ | <u>*USMC 423' SOUTH OF 6-12.</u> |
| | S | _____ | T | _____ | _____ |

Register of Deeds Stamp & File Number

4. Lot No. _____, Recorded Plat _____
 5. Private Claims _____

	A	B	C	D	E	F	G	H	I	J	K	L	M
2	6	5	4	3	2	1							
3													
4	7	8	9	10	11	12							
5													
6	18	17	16	15	14	13							
7													
8	19	20	21	22	23	24							
9													
10	30	29	28	27	26	25							
11													
12	31	32	33	34	35	36							
13													

I, CARL F. ROSER, in a field survey on APRIL 22, 19 92, do hereby certify that under requirements of P.A. 74, Michigan P.A. of 1970, the corner points mentioned in lines 1 and 2 above were in conformance with regulations and rules therefore as required in the current manual of survey instructions of the United States Department of the Interior, Bureau of Land Management or by a decree of a Court of Law and/or that the corner points mentioned in lines 3, 4 and 5 above were in conformance with the rules of the Michigan Board of Land Surveyors or by a Decree of a Court of Law; established, re-established, monumented, re-monumented, recovered, found as expressed below:

NOTE: Not more than 4 corners, all in the same town and range, may be recorded on this certificate.


A. Description of original monument and accessories and/or subsequent restoration:
6-12

B. Description of corner evidence found and/or method applied in restoring or reestablishing corner:
6-12

FOUND & ACCEPTED 2" PIPE FOR 1/4 CORNER COMMON TO SEC'S 33 AND 34. CTR N-S GRAVEL ROAD IS 2' WEST. CORNER FITS 1969 AND 1990 SURVEYS IN SEC 33 BY EDMANDS ENGR (WADE-TRIM/EDMANDS) AND 1989 SURVEY IN SEC 33 BY MILLER LAND SURVEYS (OSCODA).	RESTORED U.S. MEANDER CORNER COMMON TO FRL. SEC'S 33 & 34 PER 1911 G.H. HOLLISTER WIT AND EDMANDS ENGR (1969) & RICHARD L. MILLER (1989) SURVEYS IN SE 1/4 OF FRL SEC 33. FITS 6LD DISTANCE AND SEC LINE DIRECTION TO NORTH, REAL CLOSE. COR IS IN LINE WITH CTR OF GRAVEL ROAD, LOOKING NORTH. N-S, 4 STD B-W R/W FM IS 33' EAST.
---	--

C. Description of monument for corner and accessories established to perpetuate locating the position of the corner:
6-12

FD OLD 2" PIPE.	SET DNR MON & STUDDED STEEL FN POST.
SE COR CONC SLAB N80°W 54.2'	SW COR BRICK HOUSE FOUNDATION N45°W 129.2'
19" ASH N35°W 50.88'	*44" R OAK N30°W 106.52'
5" ASH (CLP4) N40°E 51.96'	12" ASH N05°W 23.38'
4" ASH EAST 36.41'	5" ASH N50°E 32.37'
	1/4 COR TO SEC'S 33 & 34 N02°37'E 423.04'
	*=PROBABLE GHH 1911 WIT.

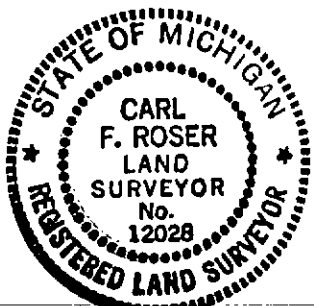

Signed by Carl F. Roser 9-25-92 Date _____
 Surveyor's Michigan License No. 12028