

LAND CORNER RECORDATION CERTIFICATE
Filing Requirement of Act 74, Mich. P.A. 1970


For corners in
ARENAC
 (County)

Located In: _____ Corner Code ##

1. Public Land Survey	T	<u>19N</u>	R	<u>6E</u>	C-12, C-13
	T	_____	R	_____	E-12
	T	_____	R	_____	_____
	T	_____	R	_____	_____
2. Property Controlling in Section	S	_____	T	_____	_____
	S	_____	T	_____	_____
3. Miscellaneous Property in Sec.	S	_____	T	_____	_____
	S	_____	T	_____	_____

Register of Deeds Stamp & File Number

4. Lot No. _____, Recorded Plat _____
 5. Private Claims _____

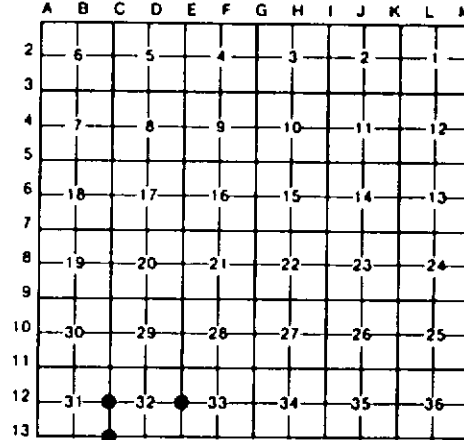

I, CARL F. ROSER, in a field survey on FEBRUARY 3, 19 92, do hereby certify that under requirements of P.A. 74, Michigan P.A. of 1970, the corner points mentioned in lines 1 and 2 above were in conformance with regulations and rules therefore as required in the current manual of survey instructions of the United States Department of the Interior, Bureau of Land Management or by a decree of a Court of Law and/or that the corner points mentioned in lines 3, 4 and 5 above were in conformance with the rules of the Michigan Board of Land Surveyors or by a Decree of a Court of Law; established, re-established, monumented, re-monumented, recovered, found as expressed below:

NOTE: Not more than 4 corners, all in the same town and range, may be recorded on this certificate.

A. Description of original monument and accessories and/or subsequent restoration.

*NOTE: SEE G.H.H. FIELD BOOKS (NO'S 2 & 6) WHICH ARE LOCATED IN DRAWER AT REG OF DEEDS & BLUEPRINT OF SAID SURVEY WHICH IS IN POSSESSION OF MARSON SMITH. (MI DNR PURCHASED THE SMITH PROPERTIES & OBTAINED XEROX COPY OF BLUEPRINT)

HOLLISTER'S 1911 SURVEY WAS FOR S.E. SYMONS OF SAGINAW, MI AND ENCOMPASSED FRL SEC'S 4,5,6 (T18N-R6E) & SEC 32 & FRL SEC 33 (T19N-R6E).

B. Description of corner evidence found and/or method applied in restoring or reestablishing corner.

<p>C-12 RESTORED 1/4 COR CORN TO SEC'S 31 & 32 AT PROP MEA TO CO SURVEYOR GEO. H. HOLLISTER (1911) DISTANCES 1/2 MILE TO N & S. AND ON LINE OF OLD FN'S TO N & S (AVG LINE OF FN IN LARGE TREES TO SOUTH). FD PIECES OF BROKEN (SMALL) GLASS, CROCKERY, & B-W, 1.5' DEEP. COR FALLS ON APPROX CTR OF CO RD LOOKING WEST. CTR OF ROAD (N-6) TO SOUTH IS 28'E.*</p>	<p>C-13 FD & ACCEPTED 4" STEEL PIPE FN CORNER. ON S'LY EDGE DITCH W/WATER TO WEST FOR SEC COR CORN TO SEC'S 31 & 32 (T19N-R6E) & SEC'S 5 & 6 (T18N-R6E). COR IS IN LINE WITH TWO 4" ST PIPE POSTS TO SOUTH & WITH FOUR 4" ST PIPE POSTS TO WEST.*</p>	<p>E-12 RESTORED E 1/4 COR OF SEC 32 PER 1911 G.H. HOLLISTER SURVEY. COR FALLS IN OLD N-S WOVEN WIRE FN ON STEEL FENCE POSTS. CTR OF MOST N'LY POINT OF 2-TRACK TRAIL ON DIKE IS 350'± SOUTH & 60'± WEST. COR FALLS IN 1.5'± OF WATER AND IN CATTAILS & WILLOW BRUSH AND TREES.*</p>
---	---	--

C. Description of monument for corner and accessories established to perpetuate locating the position of the corner.

<p>C-12 DROVE 1" X 48" GALV PIPE W/RLS CAP. 12" MAPLE (CLP 6) N50°W 57.93' 16" W OAK N20°W 43.93' 13" W ASH (CLP 3) S50°E 77.19' NW COR 4" x 4" STL GATE POST IN CONC (N'LY POST) S05°E 150.93' SET CED POST W/ LOC TAG. SOUTH 33'</p>	<p>C-13 FD 4" STEEL PIPE COR FN POST CLAMPED ON LOC TAG. SW COR CONC HEAD WALL S80°E 26.5' NW COR CONC HEAD WALL N64°E 29.1' CTR N-S DITCH BERM (SPOIL FROM DITCH) RD 16 EAST 36'</p>	<p>E-12 DR 1" X 60" GALV PIPE W/ALUM DNR CAP & SET CED POST. 7" ASH S65°E 66.8' 7" ASH S45°E 50.6' 3" ASH S15°W 56.5' 9" ASH S50°W 62.0'</p>
--	--	--

Signed by Carl F. Roser 9-25-92 Date _____
 Surveyor's Michigan License No. 12028

