LAND CORNER RECORDATION CERTIFICATE

Filing Requirement of Act 74, Mich. P.A. 1970

For corners in
ARENAC
(County)

	Located In:	Corner Code ##
1. Public Land Survey	T 19N R 6E	B-13
	T ___ R ___	
	T ___ R ___	
	T ___ R ___	
2. Property Controlling	S 31 T ___ R ___	15
in Section	S ___ T ___ R ___	
3. Miscellaneous	S 31 T ___ R ___	*USMC 1386.1' W
Property in Sec.	S ___ T ___ R ___	OF B-13

Register of Deeds Stamp & File Number

4. Lot No. _____ , Recorded Plat _____
5. Private Claims _____

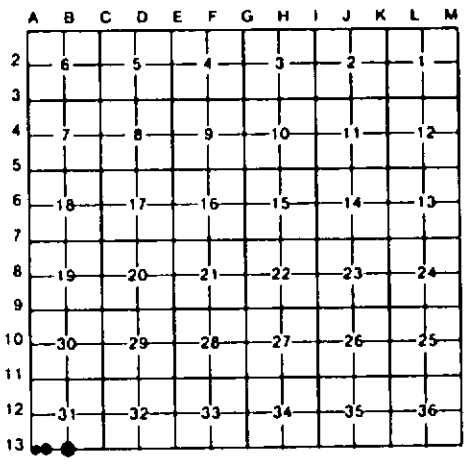

I, CARL F. ROSER, in a field survey on APRIL 30, 19 92, do hereby certify that under requirements of P.A. 74, Michigan P.A. of 1970, the corner points mentioned in lines 1 and 2 above were in conformance with regulations and rules therefore as required in the current manual of survey instructions of the United States Department of the Interior, Bureau of Land Management or by a decree of a Court of Law and/or that the corner points mentioned in lines 3, 4 and 5 above were in conformance with the rules of the Michigan Board of Land Surveyors or by a Decree of a Court of Law; established, re-established, monumented, re-monumented, recovered, found as expressed below:

NOTE: Not more than 4 corners, all in the same town and range, may be recorded on this certificate.

A. Description of original monument and accessories and/or subsequent restoration:

B-13
15
*

B. Description of corner evidence found and/or method applied in restoring or reestablishing corner:

B-13
RESTORED S 1/4 COR OF SEC 31 AT PROPORTIONATE MEASURE & ON LINE BETWEEN FD W 1/8 COR ON SOUTH LINE SEC 31 & SE COR OF SEC 31.

15
FD 1" SHAFT (IN LINE WITH OLD FN TO NORTH AND NEW FN TO WEST) FOR W 1/8 COR ON SOUTH LINE OF FRL SEC 31 (SW COR OF E 1/2 OF FRL SW 1/4 OF FRL SEC 31). CTR OF N-S TRAIL ROAD IS 18' EAST.

*
REESTAB U.S.M.C. ON SOUTH LINE OF FRL SEC 31 AT RECORD U.S. DIST W OF SE SEC 31 (61.75 CHS) AND ON LINE ACROSS SE COR SEC 31 & W 1/8 COR ON SOUTH LINE SEC 31. U.S.M.C. REESTAB'D BY ABOVE METHOD. BEST FITS U.S. MEANDER'S TO U.S.M.C. ON WEST LINE OF FRL SEC 31. CTR OF N-S TRAIL IS 60' ± EAST. E-W BARBED WIRE FN IS 1.4' SOUTH.

C. Description of monument for corner and accessories established to perpetuate locating the position of the corner:

B-13
DROVE 1" X 48" GALV PIPE W/ALUM DNR CAP & SET CED POST.

15" MAPLE	N15°W	10.7'
8" MAPLE	N60°E	16.7'
3" MAPLE	SOUTH	7.3'
3" ASH	S60°W	16.0'

15
FD 1" SHAFT W/DIMPLE & BEAR IN BETWEEN ROOTS ON SE SIDE OF 48" MAPLE.

25" MAPLE	N80°E	49.41'
POWER POLE	S05°W	63.04'
4" ELM	S30°W	15.22'
USMC. DNR MON	N88°39'W	41.35'

*
DR 1" X 48" GALV PIPE & STUDDED STL FENCE POST.

11" MAPLE	N20°W	10.99'
8" MAPLE	N25°E	9.72'
20" SWP OAK	S35°W	16.93'
1/8 COR. FD 1" SHAFT W/GEAR IN TREE ROOTS	S88°39'E	41.35'

STATE OF MICHIGAN
CARL F. ROSER
LAND SURVEYOR
No. 12028
REGISTERED LAND SURVEYOR

Signed by Carl F. Roser 9-25-92 Date _____

Surveyor's Michigan License No. 12028

FORM APPROVED BY MICHIGAN STATE BOARD OF LAND SURVEYORS, JAN. 28, 1971
REVISED MAY 14, 1975
REVISED JAN., 1983