LAND CORNER RECORDATION CERTIFICATE

Filing Requirement of Act 74, Mich. P.A. 1970

For corners in
ARENAC
(County)

	Located In:	Corner Code ##
1. Public Land Survey	T 19N R 6E	C-11
	T ___ R ___	
	T ___ R ___	
	T ___ R ___	
2. Property Controlling	S 31 T ___ R ___	9, 13, 16
in Section	S ___ T ___ R ___	
3. Miscellaneous	S ___ T ___ R ___	
Property in Sec.	S ___ T ___ R ___	

Register of Deeds Stamp & File Number

4. Lot No. _____ , Recorded Plat _____
5. Private Claims _____

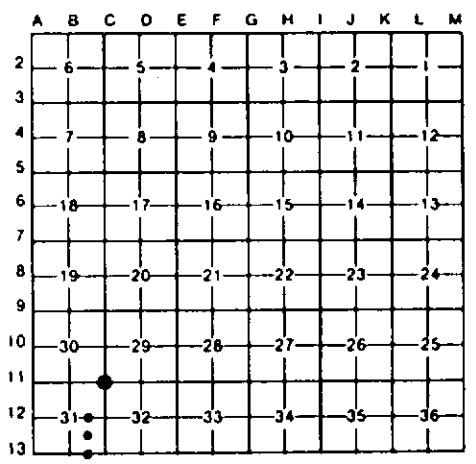

I, CARL F. ROSER , in a field survey on APRIL 30 , 19 92 , do hereby certify that under requirements of P.A. 74, Michigan P.A. of 1970, the corner points mentioned in lines 1 and 2 above were in conformance with regulations and rules therefore as required in the current manual of survey instructions of the United States Department of the Interior, Bureau of Land Management or by a decree of a Court of Law and/or that the corner points mentioned in lines 3, 4 and 5 above were in conformance with the rules of the Michigan Board of Land Surveyors or by a Decree of a Court of Law; established, re-established, monumented, re-monumented, recovered, found as expressed below:

NOTE: Not more than 4 corners, all in the same town and range, may be recorded on this certificate.

A. Description of original monument and accessories and/or subsequent restoration:

C-11	9	13	16
RESTORED NW CORNER OF SEC 32 AT FN'S E-W-S. FITS (1911) G.H. HOLLISTER SURVEY.	ESTABLISHED NW COR OF E 1/2 OF SE 1/4 OF SEC 31 EQUIDISTANT AND ON LINE BETWEEN 1/4 COR TO EAST & CTR OF SEC TO WEST. COR IS IN LINE W/OLD N-S FN REMAINS TO SOUTH (± 1') AND FALLS IN APPROX CTR OF E-W CO ROAD (STOVER RD).	ESTABLISHED CTR OF SE 1/4 OF SEC 31 PER STANDARD BLM INSTRUCTIONS. N-S, BARBED WIRE FN IS 1' WEST. COR IS IN LINE W/OLD FN REMAINS TO NORTH FOR 1/4 MILE.	ESTABLISHED SW COR OF E 1/2 OF SE 1/4 OF SEC 31 AT PROPORTIONATE MEASURE & ON LINE BETWEEN FD W 1/8 COR ON SOUTH LINE SEC 31 & SE COR OF SEC 31. WILDLIFE TECH TO SET CED POST W/LOC TAG BY CORNER.

B. Description of corner evidence found and/or method applied in restoring or reestablishing corner:

C-11	9	13	16
RESTORED NW CORNER OF SEC 32 AT FN'S E-W-S. FITS (1911) G.H. HOLLISTER SURVEY.	ESTABLISHED NW COR OF E 1/2 OF SE 1/4 OF SEC 31 EQUIDISTANT AND ON LINE BETWEEN 1/4 COR TO EAST & CTR OF SEC TO WEST. COR IS IN LINE W/OLD N-S FN REMAINS TO SOUTH (± 1') AND FALLS IN APPROX CTR OF E-W CO ROAD (STOVER RD).	ESTABLISHED CTR OF SE 1/4 OF SEC 31 PER STANDARD BLM INSTRUCTIONS. N-S, BARBED WIRE FN IS 1' WEST. COR IS IN LINE W/OLD FN REMAINS TO NORTH FOR 1/4 MILE.	ESTABLISHED SW COR OF E 1/2 OF SE 1/4 OF SEC 31 AT PROPORTIONATE MEASURE & ON LINE BETWEEN FD W 1/8 COR ON SOUTH LINE SEC 31 & SE COR OF SEC 31. WILDLIFE TECH TO SET CED POST W/LOC TAG BY CORNER.

C. Description of monument for corner and accessories established to perpetuate locating the position of the corner:

C-11			9			13			16		
SET DNR MON; FD STEEL FENCE POST NNW, 2.2'.			DROVE 5/8" X 34" REROD W/RLS CAP.			DROVE 1" X 48" GALV PIPE W/RLS CAP & SET CED POST W/LOC TAG.			DROVE 1" X 48" GALV PIPE W/RLS CAP AND STUDDED STEEL FN POST.		
			10" BALSAM	N W	56.3'						
7" SUGAR MAPLE	N20°W	29.0'	6" ASH(CLP 6)	N E	53.38'	5" ASH	N85°W	24.0'	4" ASH	S85°W	5.3'
6" ASH	N25°E	16.4'	7" ASH	SOUTH	36.09'	6" ASH	N45°E	18.9'	16" COTTONWOOD	N30°W	36.1'
9" MAPLE	N65°E	17.3'	SET CED POST W/			7" ASH	S70°E	24.9'	11" ASH	N30°E	33.6'
4" BEECH	S20°E	25.3'	LOC TAG.	SOUTH	33'	18" ASH	S45°W	41.3'	11" MAPLE	S35°E	20.5'

Signed by Carl F. Roser 9-25-92 Date _____

Surveyor's Michigan License No. 12028

STATE OF MICHIGAN
CARL F. ROSER
LAND SURVEYOR
No. 12028
REGISTERED LAND SURVEYOR

FORM APPROVED BY MICHIGAN STATE BOARD OF LAND SURVEYORS, JAN. 26, 1971
REVISED MAY 14, 1975
REVISED JAN., 1983