LAND CORNER RECORDATION CERTIFICATE

Filing Requirement of Act 74, Mich. P.A. 1970

For corners in ARENAC (County)

	Located In:	Corner Code #/#
1. Public Land Survey	T 19N R 6E	D-11
	T ___ R ___	
	T ___ R ___	
	T ___ R ___	
2. Property Controlling	S 29 T ___ R ___	16
in Section	S 32 T ___ R ___	1
3. Miscellaneous	S ___ T ___ R ___	
Property in Sec.	S ___ T ___ R ___	

Register of Deeds Stamp & File Number

4. Lot No. _____ , Recorded Plat _____
5. Private Claims _____

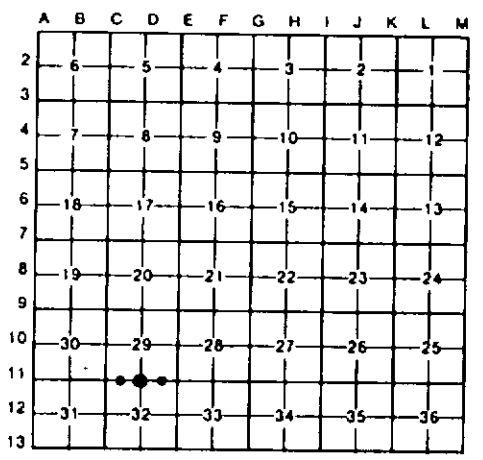

I, CARL F. ROSER, in a field survey on FEBRUARY 5, 19 92, do hereby certify that under requirements of P.A. 74, Michigan P.A. of 1970, the corner points mentioned in lines 1 and 2 above were in conformance with regulations and rules therefore as required in the current manual of survey instructions of the United States Department of the Interior, Bureau of Land Management or by a decree of a Court of Law and/or that the corner points mentioned in lines 3, 4 and 5 above were in conformance with the rules of the Michigan Board of Land Surveyors or by a Decree of a Court of Law; established, re-established, monumented, re-monumented, recovered, found as expressed below:

NOTE: Not more than 4 corners, all in the same town and range, may be recorded on this certificate.

A. Description of original monument and accessories and/or subsequent restoration:

D-11	16	1

B. Description of corner evidence found and/or method applied in restoring or reestablishing corner:

D-11	16	1
REESTABLISHED 1/4 COR COMMON TO SEC'S 29 & 32 EQUIDISTANT AND ON LINE BETWEEN SEC COR'S TO E & W. FD OLD E-W FN REMAINS, TO E & W OF HERE, JUST NORTH OF OUR RANDOM LINE. WIRE COULD BE HERE, UNDER ICE.	ESTABLISHED SE CORNER OF SW 1/4 OF SE 1/4 OF SEC 29 PER STANDARD BLM INSTRUCTIONS. COR FALLS IN 1' OF WATER AND MUD.	ESTABLISHED NW CORNER OF E 1/2 OF NW 1/4 OF SEC 32 PER STANDARD BLM INSTRUCTIONS. COR FALLS IN 1/2' OF WATER AND MUD. APPROX CORNER OF OLD FN REMAINS (E-W-S) IS 6'± NORTH AND 4'± WEST.

C. Description of monument for corner and accessories established to perpetuate locating the position of the corner:

D-11			16			1		
DROVE 1" X 96" GALV PIPE W/DNR ALUM CAP & DROVE STEEL FN POST.			DROVE 3/8" X 83" GALV PIPE W/RLS CAP & DROVE STEEL FN POST.			DROVE 1" X 84" GALV PIPE W/RLS CAP & DROVE STEEL FN POST.		
21" MAPLE	N05°E	67.7'				6" ASH	N45°W	27.9'
15" MAPLE	S75°E	35.2'	16" MAPLE W/LOC			15" MAPLE W/LOC		
8" ASH	S10°W	19.5'	TAG.	N15°W	17.5'	TAG.	N45°E	23.2'
11" ASH	S45°W	26.5'	9" ASH	N15°E	16.2'	12" ASH	N80°E	48.4'
E-W RANDOM LINE	SOUTH	0.2'	7" ASH	N75°E	20.2'	3" ASH	S25°E	19.5'
			12" ASH	S80°W	23.4'	E-W RANDOM LINE	SOUTH	0.1'
			E-W RANDOM LINE	SOUTH	0.3'			

STATE OF MICHIGAN
CARL F. ROSER
LAND SURVEYOR
No. 12028
REGISTERED LAND SURVEYOR

Signed by Carl F. Roser 9-25-92 Date _____

Surveyor's Michigan License No. 12028

FORM APPROVED BY MICHIGAN STATE BOARD OF LAND SURVEYORS, JAN. 28, 1971
REVISED MAY 14, 1975
REVISED JAN., 1983