LAND CORNER RECORDATION CERTIFICATE

Filing Requirement of Act 74, Mich. P.A. 1970

For corners in
ARENAC
(County)

Located In: Corner Code #

1. Public Land Survey — T 19N R 6E — G-9, E-9
   T ___ R ___
   T ___ R ___
   T ___ R ___
2. Property Controlling — S ___ T ___ R ___
   in Section — S ___ T ___ R ___
3. Miscellaneous — S ___ T ___ R ___
   Property in Sec. — S ___ T ___ R ___

Register of Deeds Stamp & File Number

4. Lot No. _____ , Recorded Plat _____
5. Private Claims _____

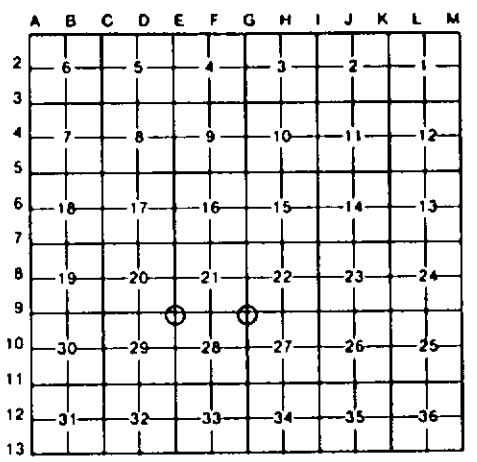

I, C.F.ROSER, in a field survey on 10-24, 19 91, do hereby certify that under requirements of P.A. 74, Michigan P.A. of 1970, the corner points mentioned in lines 1 and 2 above were in conformance with regulations and rules therefore as required in the current manual of survey instructions of the United States Department of the Interior, Bureau of Land Management or by a decree of a Court of Law and/or that the corner points mentioned in lines 3, 4 and 5 above were in conformance with the rules of the Michigan Board of Land Surveyors or by a Decree of a Court of Law; established, re-established, monumented, re-monumented, recovered, found as expressed below:

NOTE: Not more than 4 corners, all in the same town and range, may be recorded on this certificate.

A. Description of original monument and accessories and/or subsequent restoration:

G-9

G-9

G-9

E-9

B. Description of corner evidence found and/or method applied in restoring or reestablishing corner:

G-9

DUB. FD & ACCEPTED OLD REMNANT OF GOVT COR AS NOTED IN 1987 LAND COR RECORD AT ARENAC CO REG OF DEEDS IN L-1, PG 266; "6" X 3" POST WITH BROKEN CROCKERY AROUND SAME" (THE COR SET BY BLM. DEPENDENT 1955 RESURVEY. IS 4.4' SW). THE BLM COR (NOW 1" PIPE IN MON BOX) WAS ESTAB IN 1955 AS FOLLOWS: "THE POINT FOR THE COR OF SEC'S 21, 22 (CONT TO RIGHT)

G-9 (B. CONT)

27 & 28, T19N-R6E. WAS DETERMINED AT THE INTERSEC OF RDS. BEARING E, W & S." THIS SURVEYOR HAS NO PATIENCE WITH BLM SURVEYORS WHO PURPORT TO PERFORM A DEPENDENT RESURVEY, YET MAKE NO RESPONSIBLE ATTEMPT TO SEARCH THE OLD CO. SURVEYORS RECORDS, OR MAKE A FIELD SEARCH FOR SAID CORNERS. ANYONE CAN SPIN AROUND & PLUNK AN IR IN A (CONT TO RIGHT)

G-9 (B. CONT.)

RD INTERSEC. THE BIT SURFACE RD IN THIS AREA (MANOR ROAD) HAS A LIFT ON IT AND THE BLM BRASS CAP MONUMENT HAS BEEN RAISED W/1" PIPE W/ MON BOX. CTR OF GRVL RD BEARING SOUTH IS 2' WEST. CTR OF E-W BIT SURFACE RD IS 2' S. THE N1/4 COR OF SEC 28 (FD IR) FITS S.P. POSITION BETW FD NW COR OF SEC 28 & FD CROCKERY GLASS, POST, ETC FOR NE COR OF SEC.

E-9

FD 3/4" "T" IRON; FALLS IN CTR OF E-W GRAVEL ROAD. FITS 1915 SURVEY OF N LINE OF SEC 29 BY CO. SURVEYOR G.H. HOLLISTER.

C. Description of monument for corner and accessories established to perpetuate locating the position of the corner:

G-9

FD CROCKERY AND GLASS; RAISED W/ 1"X 21" PIPE W/LS CAP OVER SET 5/8"X 34" REROD.

14"R PINE	N25°E	56.13'
4"PLUM TREE	N40°E	53.76'
20"MAPLE	S14°W	88.52'
FD 1" PIPE (BLM) IN MON BOX	S39°59'W	4.24'

G-9

G-9

E-9

FD 3/4" T IRON.

9" SPRUCE	N25°W	44.53'
10" SWP OAK	N20°E	62.02'
5" ELM	S35°E	38.73'
7" B CHERRY	S45°W	47.64'

Signed by Carl F. Roser 12028 8-2-92 Date

Surveyor's Michigan License No. _____

STATE OF MICHIGAN
CARL F. ROSER
LAND SURVEYOR
No. 12028
REGISTERED

FORM APPROVED BY MICHIGAN STATE BOARD OF LAND SURVEYORS, JAN. 28, 1971
REVISED MAY 14, 1975
REVISED JAN. 1983