LAND CORNER RECORDATION CERTIFICATE

Filing Requirement of Act 74, Mich. P.A. 1970

For corners in ARENAC (County)

	Located In:	Corner Code ##
1. Public Land Survey	T 19N R 6E	6-10, 6-11
	T ___ R ___	
	T ___ R ___	
	T ___ R ___	
2. Property Controlling	S 28 T ___ R ___	2, 14
in Section	S ___ T ___ R ___	
3. Miscellaneous	S ___ T ___ R ___	
Property in Sec.	S ___ T ___ R ___	

Register of Deeds Stamp & File Number

4. Lot No. _____ , Recorded Plat _____
5. Private Claims _____

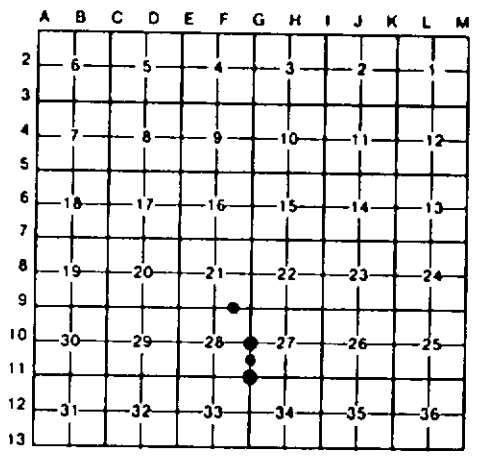

I, CARL F. ROSER, in a field survey on APRIL 22, 19 92, do hereby certify that under requirements of P.A. 74, Michigan P.A. of 1970, the corner points mentioned in lines 1 and 2 above were in conformance with regulations and rules therefore as required in the current manual of survey instructions of the United States Department of the Interior, Bureau of Land Management or by a decree of a Court of Law and/or that the corner points mentioned in lines 3, 4 and 5 above were in conformance with the rules of the Michigan Board of Land Surveyors or by a Decree of a Court of Law; established, re-established, monumented, re-monumented, recovered, found as expressed below:

NOTE: Not more than 4 corners, all in the same town and range, may be recorded on this certificate.

A. Description of original monument and accessories and/or subsequent restoration:

6-10

6-11

(*B* CONTINUED)
CTR OF N-S GRAVEL RD IS 2' +
E. COR FALLS IN CTR OF E-W
GRAVEL ROAD.

14

2

B. Description of corner evidence found and/or method applied in restoring or reestablishing corner:

6-10

FD RR SPK (ADDED 5/8" X 34" REROD) FOR 1/4 COR COMMON TO SEC'S 27 & 28. OLD FN COR REMAINS (WITH OLD FN TO N & W) IS 32' WEST. COR FALLS IN CTR N-S GR RD & FITS PRIOR SURVEY BY RLS. RICHARD MILLER.

6-11

FD 3/8" X 4 1/2" LONG BOLT W/ SQ. HEAD IN TOP OF OLD WOOD POST (PROBABLY CEDAR), 0.7' BELOW SURFACE OF RD. ACCEPTED FOR SE COR OF SEC 28. EDMANDS ENGR FOUND THIS POINT IN 1969 (JOB #5559) & ACCEPTED FOR WORK IN SEC 33. COR FITS OLD SURVEYS THIS AREA BY CO SURVEYOR GEO. H. HOLLISTER IN 1908 & 1911.
(CONTINUED IN "A")

14

FD RR SPK FOR S 1/8 COR ON EAST LINE OF SEC 28; FITS PRIOR SURVEY BY RLS. RICHARD MILLER.

2

ESTABLISED NE COR OF N 1/2 OF NE 1/4 OF SEC 28 PER STANDARD BLM INSTRUCTIONS (S.P. BETW NE COR & N 1/4 COR OF SEC 28). CTR OF 25' WIDE E-W GRAVEL RD IS 2' NORTH. FD OLD FN REMAINS E & S AT POINT 33' ± SOUTH & 7' ± WEST. OLD FN REMAINS TO W ARE 7' ± WEST.

C. Description of monument for corner and accessories established to perpetuate locating the position of the corner:

6-10

FD RR SPK; ADDED 5/8" X 34" REROD W/RLS CAP.

13" MAPLE	N60°W	28.7'
12" MAPLE	N15°W	86.7'
6" MAPLE	S45°W	40.4'
POWER POLE	WEST	61.26'

6-11

FD SMALL BOLT IN CED POST; DROVE 5/8" X 34" REROD W/RLS CAP.
CTR 6"X 6" METAL TELE.

RISER	N55°W	50.5'
14" SPRUCE	N30°E	86.5'
11" SPRUCE	N55°E	52.4'
15" ASH	S10°E	141.11'

14

RD RR SPK.

POWER POLE	S85°W	50.38'
4" MAPLE	N55°E	48.8'
POWER POLE	N85°E	35.3'
FD 1/2" REROD W/RLS CAP.	WEST	33.0'

2

DROVE 5/8" X 34" REROD W/LS CAP.

8" ASH	N20 W	47.2'
3" TWIN ASH	S25 E	41.9'
2" TWIN ASH	S40 W	45.7'
SET CED POST W/ LOC TAG.	SOUTH	33.0'

Signed by Carl F. Roser 8-07-92 Date _____

Surveyor's Michigan License No. 12028

STATE OF MICHIGAN
CARL F. ROSER
LAND SURVEYOR
No. 12028
REGISTERED LAND SURVEYOR

FORM APPROVED BY MICHIGAN STATE BOARD OF LAND SURVEYORS, JAN. 28, 1971
REVISED MAY 14, 1975
REVISED JAN., 1983