

**LAND CORNER RECORDATION CERTIFICATE**  
**Filing Requirement of Act 74, Mich. P.A. 1970**

For corners in  
**ARENAC**


| (County)                           | Located In:                 | Corner Code --  |
|------------------------------------|-----------------------------|-----------------|
| 1. Public Land Survey              | T <u>19N</u> R <u>6E</u>    | <u>A-9, B-9</u> |
|                                    | T _____ R _____             | _____           |
|                                    | T _____ R _____             | _____           |
|                                    | T _____ R _____             | _____           |
| 2. Property Controlling in Section | S <u>19</u> T _____ R _____ | <u>15</u>       |
|                                    | S <u>30</u> T _____ R _____ | <u>3</u>        |
| 3. Miscellaneous Property in Sec.  | S _____ T _____ R _____     | _____           |
|                                    | S _____ T _____ R _____     | _____           |

Register of Deeds Stamp & File Number

4. Lot No. \_\_\_\_\_, Recorded Plat \_\_\_\_\_  
 5. Private Claims \_\_\_\_\_

I, CARL F. ROSER, in a field survey on OCTOBER 23, 19 91  
do hereby certify that under requirements of P.A. 74, Michigan P.A. of 1970, the corner points mentioned in lines 1 and 2 above were in conformance with regulations and rules therofore as required in the current manual of survey instructions of the United States Department of the Interior, Bureau of Land Management or by a decree of a Court of Law and/or that the corner points mentioned in lines 3, 4 and 5 above were in conformance with the rules of the Michigan Board of Land Surveyors or by a Decree of a Court of Law, established, re-established, monumented, re-monumented, recovered, found as expressed below:

**NOTE: Not more than 4 corners, all in the same town and range, may be recorded on this certificate.**

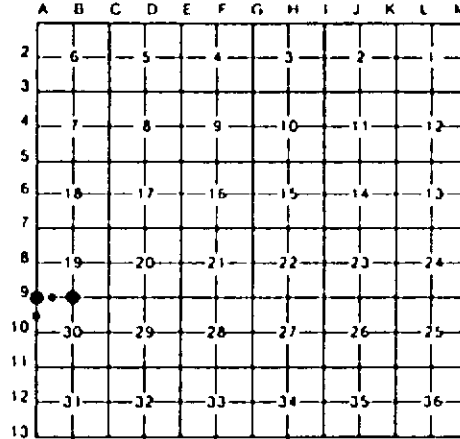

A. ~~Description of original monument and accessories and/or subsequent restoration:~~  
 A-9 B-9 15

(\*B\* CONTINUED)  
 OF GRAVEL RD. LOOKING EAST.  
 APPROX CTR OF GRAVEL RD.  
 LOOKING WEST. IS 6' ± SOUTH.

B. Description of corner evidence found and/or method applied in restoring or reestablishing corner:

| A-9   | B-9   | <u>* 3</u>  | <u>* 15</u>   |
|---|---|---|---|
| FD & ACCEPTED 1/2" REROD FOR NW COR OF SEC 30. FITS ALL 3 LLOYD MCGINNIS 1973 WITS. AS RECORDED PER ACT 74, P.A. 1970 (L.I. PG 55). RLS. J.G. CAMPBELL, CERT OF SUR., L.I. PG 187, DEC. 1974, ALSO USED THIS COR & SHOWS 2 OF 3 MCGINNIS WITS. COR FALLS IN APPROX CTR OF N-S BIT SURFACE RD AND IS IN LINE W/APPROX CTR (CONTINUED IN *A*) | RESTORED N 1/4 COR OF SEC 30 AT PROPORTIONATE MEASURE TO (GLO RUN-OUT SEC), BETWEEN SEC CORNERS TO EAST & WEST. COR FALLS IN APPROX CTR OF E-W GRAVEL ROAD. | ESTABLISHED SW COR OF N 1/2 OF NW 1/4 OF SEC 30, MIDWAY & ON LINE BETWEEN SEC COR TO NORTH AND 1/4 COR TO SOUTH. COR FALLS IN APPROX CTR OF N-S BIT SURFACE RD. CTR OF POWERLINE LOOKING EAST IS 15' SOUTH. | ESTAB SW COR OF SE 1/4 OF FRL SW 1/4 OF SEC 19 ON LINE BETW S 1/4 COR & SW COR OF SEC 19 & AT PROPORTIONATE MEA TO U.S. (GLO RUN-OUT SEC). CTR OF 26' WIDE E-W GRAVEL RD IS 2' SOUTH. |

C. Description of monument for corner and accessories established to perpetuate locating the position of the corner.

| A-9   | B-9   | <u>* 3</u>  | <u>* 15</u>  |
|---|---|---|--|
| FD 1/2" REROD. ADDED 1" X 18" GALV PIPE W/RLS CAP.<br>*POWER POLE N50°E 57.07'<br>*RD SIGN POST S40°E 35.0'<br>*POWER POLE N75°W 136.74'<br>FD 1/2" BOLT S00°45'E 5.37'<br>CTR OF N-S BIT SURFACE RD EAST 1' ±<br>*RLS. L.D. MCGINNIS WITS. | DR 5/8" X 34" REROD W/RLS CAP.<br>2" BALSAM N25°W 33.1'<br>2" BALSAM N05°E 37.3'<br>6" J PINE S45°E 55.6'<br>2" BALSAM S25°W 63.8'<br>FD 1/2" REROD BY 1 1/2" X 36" PIPE W/SIGN S12°10'W 36.02'<br>DROVE 5/8" X 34" REROD W/RLS CAP & SET CED POST W/LOC TAG. S02°24'W 33.00' | DROVE 5/8" X 34" REROD W/RLS CAP.<br>7" ASH N50°W 68.03'<br>7" ASH N75°E 68.83'<br>POWER POLE S70°E 46.74'<br>SET CED POST W/LOC TAG EAST 33'<br>13" MAPLE S85°W 53.25' | DROVE 5/8" X 34" REROD W/RLS CAP.<br>4" BALSAM N20°E 76.3'<br>10" W PINE N50°E 100.3'<br>6" B CHERRY S25°E 55.3'<br>SET CED POST W/LOC TAG NORTH 33' |

Signed by Carl F. Roser 9-25-92 Date  
 Surveyor's Michigan License No. 12028

