

LAND CORNER RECORDATION CERTIFICATE

FILING REQUIREMENT OF ACT 74, MICH. P.A.1970

FOR CORNERS OF --:	LOCATED IN --:	CORNER CODE NUMBER
1. PUBLIC LAND SURVEY. 36	T. 20 N. R. 3 E.	K-12; L-12
2. PROPERTY CONTROLLING IN SECTION 36	T. 20 N. R. 3 E.	5
3. MISCELLANEOUS PROPERTY IN SECTION	T. S. R. W.	
4. LOT NO. _____	RECORDED PLAT _____	
5. PRIVATE CLAIMS _____		

REGISTER OF DEEDS STAMP AND FILING NUMBER _____

I, KENNETH J. OSTLING, do hereby certify that under requirements of P.A. 74, Michigan P.A. of 1970, the corner points mentioned in lines 1 and 2 above were, in a field survey on FEBRUARY 25, 1982, established, re-established, monumented, re-monumented, recovered or restored as expressed below and in conformance with regulations and rules therefore as required in the current manual of survey instructions of the United States Department of the Interior, Bureau of Land Management or by a decree of a court of law. Furthermore, that the corner points mentioned in lines 3, 4 and 5 above were, in a field survey on _____, 19____, found, recovered, restored, established or re-established as expressed below and in conformance with the rules of the Michigan State Board of Registration for Land Surveyors or, by a Decree of a Court of law:

A. Description of original monument and accessories and/or subsequent restoration:

B. Description of corner evidence found and/or method applied in restoring or re-establishing corner:

- K-12 SET BY SINGLE PROPORTIONATE MEASUREMENTS BETWEEN SECTIONS CORNERS. FALL ABOUT 106' E AND 30' S. OF OLD FENCE INTERSECTION BUT COULD FIND NO JUSTIFICATION FOR ANY LOCATION EXCEPT AS SET. FENCES HIGHLY UNRELIABLE IN THIS SECTION, AND ACCEPTANCE OF FENCE CORNER WOULD CREATE GREAT DISTORTION IN SECTION SUBDIVISION.
- L-12 SET CORNER AT CALCULATED INTERSECTION OF TRUE 1/4 LINE, PER STANDARD SURVEY PROCEDURE.
- 5 SET BY STANDARD SURVEY PROCEDURE FOR THE SUBDIVISION OF SECTIONS.


C. Description of monument for corner and accessories established to perpetuate locating the position of the corner:

<u>5</u>	<u>K-12</u>	<u>L-12</u>
SET 5/8" X 36" IRON BAR W/CAP	SET DNR MONUMENT	SET 5/8" X 36" IRON BAR W/CAP
8" R. OAK N5°E 19.4'	7" R. MAPLE S3°W 9.4'	7" R. OAK N84°E 13.0'
5" R. MAPLE S77°W 11.8'	12" R. OAK N11°E 11.8'	7" W. ASH S34°E 10.6'

SIGNED BY *Kenneth J. Ostling*

DATE 9/2

SURVEYOR'S MICHIGAN REGISTRATION NO. #10068

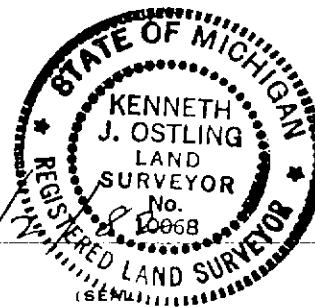

FOR STATE AND UNITED STATES AGENCIES:

SIGNED BY _____ DATE _____

APPROVED AND SIGNED BY _____ DATE _____

CHIEF OF SURVEY PARTY

MICHIGAN REGISTERED LAND SURVEYOR

(SEAL)

SURVEYOR'S MICHIGAN REGISTRATION NO. _____

ARENAC COUNTY