

LAND CORNER RECORDATION CERTIFICATE

+ Filing Requirement of Act 74, Mich. PA 1970

For Corners In:
Arenac Located In _____ Corner Code # _____
 (County)



- | | | | | | |
|--------------------------------------|---|------------|---|-----------|-----------|
| 1. Public Land Survey | T | <u>20N</u> | R | <u>3E</u> | <u>D9</u> |
| | T | _____ | R | _____ | _____ |
| 2. Property Controlling in Section | S | _____ | T | _____ | R |
| | S | _____ | T | _____ | R |
| 3. Miscellaneous Property in Section | S | _____ | T | _____ | R |
| | S | _____ | T | _____ | R |

4. Lot No: _____ Recorded Plat: _____

5. Private Claims: _____

I, Craig W. McVean, in a field survey on Sept. 13, 2004 do hereby state that under requirements of PA 74, Michigan PA of 1970, the corner points mentioned in lines 1 and 2 above were in conformance with regulations and rules therefore as required in the current manual of survey instructions of the United States Department of the Interior, Bureau of Land Management or by a decree of a Court of Law and/or that the corner points mentioned in lines 3, 4 and 5 above were in conformance with the rules of the Michigan Board of Land Surveyors or by a Decree of a Court of Law; established, re-established, monumented, recovered, found as expressed below:

NOTE: Not more than 2 corners, all in the same town and range, may be recorded on this certificate.

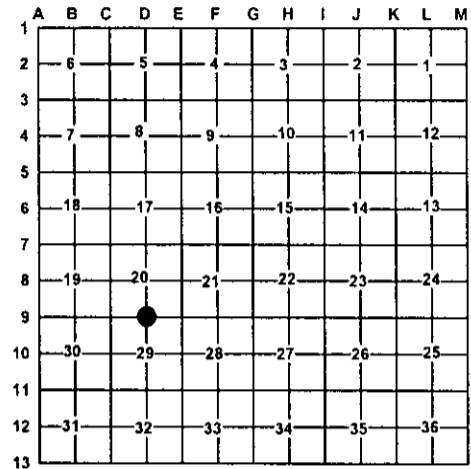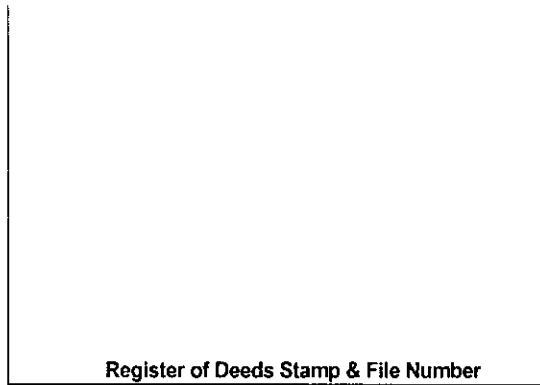

A. Description of original monument and accessories and/or subsequent restoration:

- D9 – GLO – Set ¼ Post – J. Mullett – 1846
- W. Pine 30° S42° 11 L.
- W. Pine 24° N56°E 21 L.
- CPC Drawing #SF16944, Sheet 95 – 1968 & Field notes
- Set iron from OBT's; N25°W 131.6'- 18" W. Pine;
- S36°W 58.3'- 8" Oak; S75°E 21.0'-10" Maple

B. Description of corner evidence found and/or method applied in restoring or re-establishing corner:

- D9 – ¼ Corner common to Sec. 20 & 29 – Fd. 3/8" x 18" iron rebar that fits CPC's Oak and W. Pine BT's. Distance to Maple measures 29' not 21'. 3/8" rebar fits remains of 2 WPS's that agree with GLO BT's in size, bearing and distance from iron. Measure East 268 ft (276' – GLO) to E. side of 4'-6" wide Dry Stream bed coarse SSW. N-S fence is 8' E & E-W fence is 23'± South. 3/8" rebar is accepted as a careful and faithful perpetuation of the position of the original corner.

C. Description of monument for corner and accessories established to perpetuate locating the position of the corner:

- D9 – Replaced 3/8" x 18" iron rebar with 4" DNR Alum. Cap on 1" x 36" Galv. iron pipe.
- NE 1' to set Blue Carsonite Post
- S89°E 28.91' to Fd. nail in N. side 30" R. Maple (CPC)
- N27°W 132.08' to set N & T in W. side 28" W. Pine (CPC)
- N84°W 15.11' to set N & T in N. side 7" W. Pine
- N7°E 15.31' to set N & T in E. side Tw. 6" W. Pine scribed 'XBT'
- S72°E 64.58' to set N & T in S. side 20" W. Pine
- S45°W 7.9' to set Nail in centerline ± remains 30" WPS (GLO)
- N58°E 14.6' to centerline ± remains 24" WPS (GLO)



Signed by: Craig W. McVean
 Surveyor's Michigan License No.: 39088

Date: 2/7/2005