

LAND CORNER RECORDATION CERTIFICATE

* Filing Requirement of Act 74, Mich. PA 1970

For Corners In: Arenac Located In _____ Corner Code # _____
(County)

1. Public Land Survey	T	<u>20N</u>	R	<u>3E</u>	<u>E10</u>
	T	_____	R	_____	_____
2. Property Controlling in Section	S	_____	R	_____	_____
	S	_____	R	_____	_____
3. Miscellaneous Property in Section	S	_____	R	_____	_____
	S	_____	R	_____	_____


Register of Deeds Stamp & File Number

4. Lot No: _____ Recorded Plat: _____

5. Private Claims: _____

I, Craig W. McVean, in a field survey on Aug. 24, 2004 do hereby state that under requirements of PA 74, Michigan PA of 1970, the corner points mentioned in lines 1 and 2 above were in conformance with regulations and rules therefore as required in the current manual of survey instructions of the United States Department of the Interior, Bureau of Land Management or by a decree of a Court of Law and/or that the corner points mentioned in lines 3, 4 and 5 above were in conformance with the rules of the Michigan Board of Land Surveyors or by a Decree of a Court of Law; established, re-established, monumented, recovered, found as expressed below:

NOTE: Not more than 2 corners, all in the same town and range, may be recorded on this certificate.

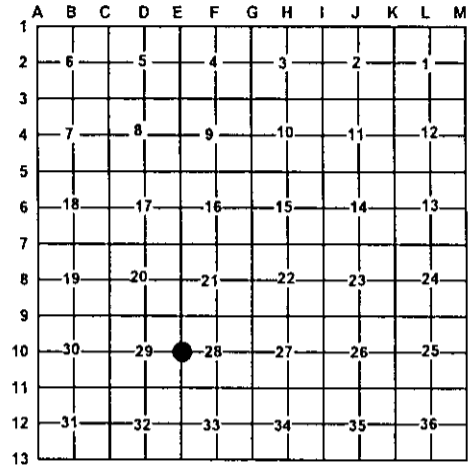

A. Description of original monument and accessories and/or subsequent restoration:

- | | |
|---|--|
| <p><u>E10</u> - GLO - Set 1/4 Post - J. Mullett - 1846 -
W. Pine 4" N59°E 14 L.
W. Pine 4" S48°W 18 L.
- CSR - FB. 8, P. 39 - 1909 - Fd. both original wits. 39.56 CH to 'E9'
- CSR - FB. 14, P. 51 - 1915 - Fd. both original Gov. wits. Beer bottle placed as corner with papers in bearing data of survey.</p> | <p>- MDOT Wit. Card - C. F. Roser - 1964 (LCRC L. 1, p. 240 - 1984) - Fd. beer bottle w/ note and point of wood stake, set 5' of 2" pipe and coke bottle w/ old and new note inside. Marked cedar guard post. This corner fits calls in old survey notes by Hollistor (Co. Sur. - 1915) 12" J. Pine N70°W 64.91'; 7" J. Pine N5°W 76.74'</p> |
|---|--|

B. Description of corner evidence found and/or method applied in restoring or re-establishing corner:

E10 - 1/4 Corner common to Sec. 28 & 29 -- Fd. 2" I. D. iron pipe - Up 2' - per MDOT. Fit both of MDOT wit's. GLO BT's are gone. 2" Iron pipe accepted as a careful and faithful perpetuation of the position of the original corner.

C. Description of monument for corner and accessories established to perpetuate locating the position of the corner:

E10 - Drove stamped 2" Alum. cap on 5/8" x 4' long iron rebar into centerline of fd. 2" pipe
Set Blue Carsonite Post 1' N.
N64°W 64.89' to Fd. MDOT Tag in SW side 19" J. Pine (MDOT) scribed 'XBT'
N2°W 76.79' to set N & T in E side 19" J. Pine (MDOT) scribed 'XBT'
N58°E 25.15' to set N & T in NW side 9" J. Pine scribed 'XBT'
S37°E 66.37' to set N & T in NE side 8" W. Pine scribed 'XBT'
S53°W 23.79' to set N & T in N side 9" J. Pine scribed 'XBT'



Signed by: Craig W. McVean
Surveyor's Michigan License No.: 39088

Date: 2/7/2005