

LAND CORNER RECORDATION CERTIFICATE

Filing Requirement of Act 74, Mich. PA 1970

For Corners In:
Arenac Located In _____ Corner Code # _____
 (County)

1. Public Land Survey T 20N R 3E E11
 T _____ R _____
 2. Property Controlling in Section S _____ T _____ R _____
 S _____ T _____ R _____
 3. Miscellaneous Property in Section S _____ T _____ R _____
 S _____ T _____ R _____


4. Lot No: _____ Recorded Plat: _____

5. Private Claims: _____

I, Craig W. McVean, in a field survey on Nov. 3, 2004 do hereby state that under requirements of PA 74, Michigan PA of 1970, the corner points mentioned in lines 1 and 2 above were in conformance with regulations and rules therefore as required in the current manual of survey instructions of the United States Department of the Interior, Bureau of Land Management or by a decree of a Court of Law and/or that the corner points mentioned in lines 3, 4 and 5 above were in conformance with the rules of the Michigan Board of Land Surveyors or by a Decree of a Court of Law; established, re-established, monumented, recovered, found as expressed below:

NOTE: Not more than 2 corners, all in the same town and range, may be recorded on this certificate.

Register of Deeds Stamp & File Number

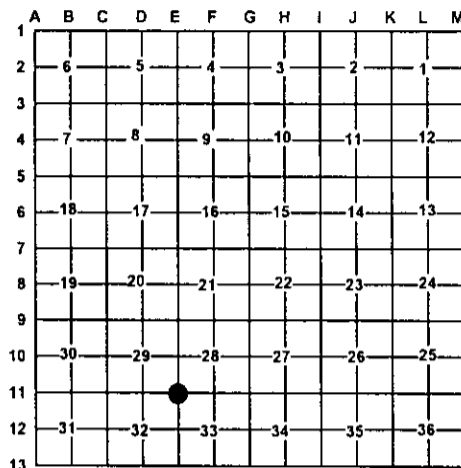

A. Description of original monument and accessories and/or subsequent restoration:


E11 – GLO – Set post – J. Mullett – 1846
 Cedar 6" S66°W 5 L.
 Cedar 6" N54°E 4 L.
 - CSR – FB #8, p. 39 – 1909 – Fd. original wit.
 - CSR – FB #14, p. 51 & 52 – 1915 – Both Gov. wit. alive. ½ Pt. bottle at post with paper inside
 - CCC Notes – 1930's – Random E. 157.07 CH. - Old section post 1.23 N.
 - MDOT Wit. Card – C. F. Roser – 1964 (LCRC L. 1, p. 237 – 1984) – Fd. 1 ¼" pipe and 8" dia. scribed wood post and pieces of broken glass mentioned in sur. notes by Hollister (Co. Sur. – 1915). Note: Hollister said he found this corner and GLO wit. This corner is also shown as an original Gov't cor. on "Rayburn Oil Well site prints" obtained from S. Ernest Lucas (RLS #4747), Mio, MI. 17" Tw. Elm S15°W 4.75'; 6" Elm S5°E 25.70'; 10" Birch S40°E 34.25'

B. Description of corner evidence found and/or method applied in restoring or re-establishing corner:

E11 – Sec. Corner common to Sections 28, 29, 32 & 33 – Fd. 1 ¼" I.D. iron pipe with cedar guard post on NE side and rotten older post bottom on N. side of pipe. Corner in swamp. Measured South 40± 10' (132' – GLO) to S. edge of swamp. Fit one MDOT wit. a Maple not an Elm and rotten stp. of the Birch. 1 ¼" pipe accepted as a careful and faithful perpetuation of the position of the original corner.

C. Description of monument for corner and accessories established to perpetuate locating the position of the corner:

E11 – Drove stamped 2" Alum. cap on 5/8" x 5' long iron rebar into centerline of fd. 1 ¼" iron pipe.
 Set Blue Carsonite Post 1' S.
 S20°W 4.64' to set N & T in W. side Tw. 10" R. Maple (MDOT)
 N60°E 25.58' to set N & T in S. side 4" Cedar
 N40°W 40.02' to set N & T in SW side 5" R. Maple scribed 'XBT'
 S24°E 67.98' to set N & T in W. side 10" R. Maple Clp. – 4 scribed 'XBT'
 S4°E 78.76' to set N & T in E. side 4" W. Pine

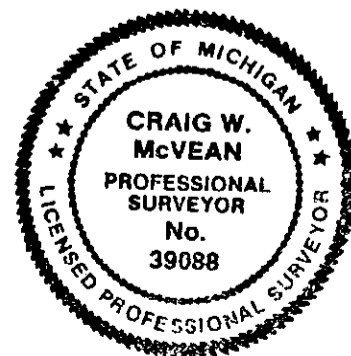

Signed by: Craig W. McVean
 Surveyor's Michigan License No.: 39088

Date: 2/7/2005