

LAND CORNER RECORDATION CERTIFICATE

Filing Requirement of Act 74, Mich. PA 1970



For Corners In:
Arenac Located In _____ Corner Code # _____
 (County)

- | | | | | | |
|--------------------------------------|---|-----|---|----|-----|
| 1. Public Land Survey | T | 20N | R | 3E | E12 |
| | T | | R | | |
| 2. Property Controlling in Section | S | T | R | | |
| | S | T | R | | |
| 3. Miscellaneous Property in Section | S | T | R | | |
| | S | T | R | | |

4. Lot No: _____ Recorded Plat: _____
 5. Private Claims: _____

I, Craig W. McVean, in a field survey on Nov. 3, 2004 do hereby state that under requirements of PA 74, Michigan PA of 1970, the corner points mentioned in lines 1 and 2 above were in conformance with regulations and rules therefore as required in the current manual of survey instructions of the United States Department of the Interior, Bureau of Land Management or by a decree of a Court of Law and/or that the corner points mentioned in lines 3, 4 and 5 above were in conformance with the rules of the Michigan Board of Land Surveyors or by a Decree of a Court of Law; established, re-established, monumented, recovered, found as expressed below:

NOTE: Not more than 2 corners, all in the same town and range, may be recorded on this certificate.

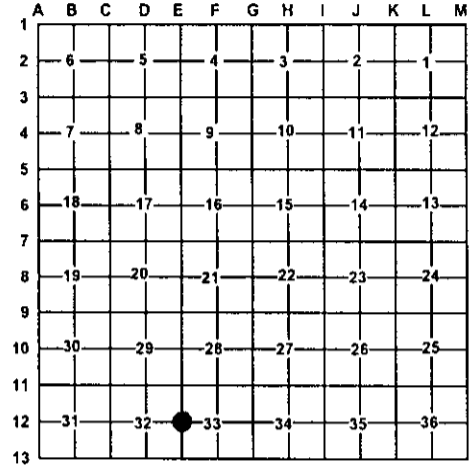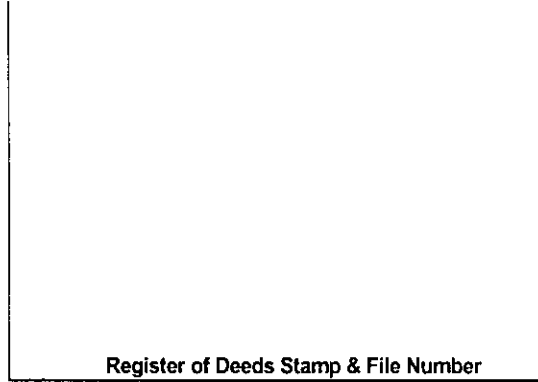

A. Description of original monument and accessories and/or subsequent restoration:
E12 – GLO – Set ¼ Post – John Mullett – 1846
 Hemlock 4" S28°E 17 L.
 Cedar 12" N83°W 7 L.

B. Description of corner evidence found and/or method applied in restoring or re-establishing corner:

E12 - ¼ Corner common to Sec. 32 & 33 – No GLO or any other evidence found. Set 4" DNR Alum. Cap on 1" x 5' long galv. iron pipe single proportion between 'E11' and 'E13'. Corner falls in swamp. Measured South 109'± (156' – GLO) to N. Bank of ditched stream – course W. Edge of swamp W & N is 45'± NNW. DNR Mon. accepted as a careful and faithful re-establishment of the position of the original corner.

C. Description of monument for corner and accessories established to perpetuate locating the position of the corner:

E12 – 4" DNR Alum. Cap on 1" x 5' long galv. iron pipe
 Set Blue Carsonite Post 1' S.
 N17°W 82.31' to set N & T in E. side 21" R. Pine scribed 'XBT'
 N40°W 40.04' to set N & T in SW side 10" R. Maple scribed 'XBT'
 N62°E 50.38' to set N & T in N. side 5" Tamarack
 S15°W 21.34' to set 18" Long 'T' iron



Signed by: Craig W. McVean
 Surveyor's Michigan License No.: 39088

Date: 2/7/2005