


LAND CORNER RECORDATION CERTIFICATE


Filing Requirement of Act 74, Mich. PA 1970

For Corners In:			
<u>Arenac</u>	Located In	Corner Code #	
(County)			
1. Public Land Survey	T <u>20N</u> R <u>3E</u>	<u>C11</u>	
	T _____ R _____	_____	_____
2. Property Controlling in Section	S _____ T _____ R _____	_____	_____
	S _____ T _____ R _____	_____	_____
3. Miscellaneous Property in Section	S _____ T _____ R _____	_____	_____
	S _____ T _____ R _____	_____	_____
4. Lot No: _____	Recorded Plat: _____		
5. Private Claims: _____			

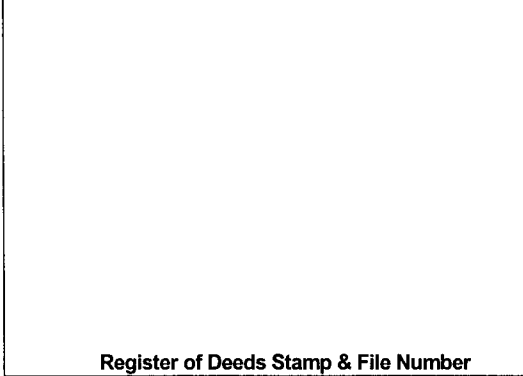

I, Craig W. McVean, in a field survey on June 9, 2005 do hereby state that under requirements of PA 74, Michigan PA of 1970, the corner points mentioned in lines 1 and 2 above were in conformance with regulations and rules therefore as required in the current manual of survey instructions of the United States Department of the Interior, Bureau of Land Management or by a decree of a Court of Law and/or that the corner points mentioned in lines 3, 4 and 5 above were in conformance with the rules of the Michigan Board of Land Surveyors or by a Decree of a Court of Law; established, re-established, monumented, recovered, found as expressed below:

NOTE: Not more than 2 corners, all in the same town and range, may be recorded on this certificate.

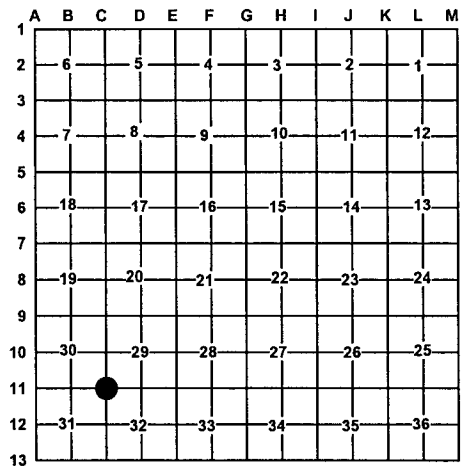

A. Description of original monument and accessories and/or subsequent restoration:
C11 – GLO – Set Post – J. Mullett – 1846
 Hemlock 14" N50°E 20 L.
 W. Pine 14" S40°W 29 L.
 - CCC Notes – 1930's – Random S. – 80 CH. – 19N and 5 1/2 L. W. of old post
 - CPC Survey – Drawing #SF18944 – Sheet 96
 1968 – Corner Set – 6" Maple S40°E 12.5';
 6" Maple N80°E 22.4'

B. Description of corner evidence found and/or method applied in restoring or re-establishing corner:
C11 – Sec. Corner common to Sec.'s 29, 30, 31 & 32 – No conclusive GLO evidence. Set 4" DNR Alum. Cap on 1" x 36" long galv. iron pipe by double proportion to GLO between section corners 1 mile N, S, E & W. Based on CCC notes they indicate that a found post would be about S65°W 64' ± of DNR Mon. No evidence of this position now. CCC notes indicates this was probably random line by others since they found posts every 20 CH's 1 mile N & E. This CCC found post way too far West to be acceptable. From DNR Mon. measured East 929' (937' – GLO) to W. Edge of stream 3-5' wide – coarse S'ly. Fits stream edge proportional within 1'. N-S single strand is 22' ± E. Single strand ends at 2" iron pipe post S22° 24' E 55.95'. DNR Monument accepted as a careful and faithful reestablishment of the position of the original corner.
 - Reference Pt. - Fd. 3/8" iron rebar per Consumer's survey is S66° 59' W 23.0' of 'C11' – 43'± W. of N-S 2-strand. This 3/8" iron based on rejected Consumer's position at 'C10' and being 1/3 distance S of rejected 'C10' position to accepted 'C13' position. 3/8" rebar not utilized as 'C11' in this survey.

C. Description of monument for corner and accessories established to perpetuate locating the position of the corner:
C11 – 4" DNR Alum. Cap on 1" x 36" galv. iron pipe.
 Set Blue Carsonite Post 1' SE
 S36°W 14.89' to set N & T in SE side Tri. 12" R. Maple scribed 'XBT'
 N59°W 15.96' to set N & T in NE side 5" Oak
 N29°E 67.15' to set N & T in NW side 6" Oak scribed 'XBT'
 N85°E 2.13' to set N & T in N side Tri. 9" R. Maple scribed 'XBT'
 S66° 59' W 23.0' to Ref. Pt. – 3/8" iron rebar
 S68° 48'E 23.45' to Fd. 3/8" rebar



Signed by: Craig W. McVean
 Surveyor's Michigan License No.: 39088

Date: 9/22/2005