

LAND CORNER RECORDATION CERTIFICATE

Filing Requirement of Act 74, Mich. PA 1970

For Corners In:
Arenac Located In _____ Corner Code # _____
 (County)

1. Public Land Survey T _____ R _____
 T _____ R _____

2. Property Controlling in Section S 29 T 20N R 3E 5
 S 29 T 20N R 3E 7

3. Miscellaneous Property in Section S _____ T _____ R _____
 S _____ T _____ R _____

4. Lot No: _____ Recorded Plat: _____

5. Private Claims: _____

I, Craig W. McVean, in a field survey on June 20, 2005 do hereby state that under requirements of PA 74, Michigan PA of 1970, the corner points mentioned in lines 1 and 2 above were in conformance with regulations and rules therefore as required in the current manual of survey instructions of the United States Department of the Interior, Bureau of Land Management or by a decree of a Court of Law and/or that the corner points mentioned in lines 3, 4 and 5 above were in conformance with the rules of the Michigan Board of Land Surveyors or by a Decree of a Court of Law; established, re-established, monumented, recovered, found as expressed below:

NOTE: Not more than 2 corners, all in the same town and range, may be recorded on this certificate.

A. Description of original monument and accessories and/or subsequent restoration:
5 - None 7 - None



B. Description of corner evidence found and/or method applied in restoring or re-establishing corner:

5 - CN 1/16 Cor., Sec. 29 - Set stamped 2" Alum. Cap on 5/8" x 34" iron rebar per standard BLM procedure. Remains of old down N-S fence is 5' ± West.

7 - N 1/16 Cor., common to Sec. 28 & 29 - Set stamped 2" Alum. Cap on 5/8" x 34" iron rebar per Standard BLM procedure.


C. Description of monument for corner and accessories established to perpetuate locating the position of the corner:

5 - 2" Alum. Cap on 5/8" x 34" rebar
 Set Blue Carsonite Post w/ Loc. tag 1' S.
 N24°E 36.00' to set N & T in W. side Tri. 12" R. Maple
 S10°E 42.43' to set N & T in W. side 6" W. Pine
 S32°W 13.58' to set N & T in NW side 10" Oak
 N64°W 63.51' to set N & T in SW side 7" W. Pine

7 - 2" Alum. Cap on 5/8" x 34" rebar
 Set Blue Carsonite Post with loc. tag 1' SE
 N30°E 19.85' to set N & T in NW side 6" R. Maple
 S70°E 54.54' to set N & T in S. side 12" R. Maple
 S21°W 36.44' to set N & T in W. side 7" R. Maple
 S86°W 49.95' to set N & T in N. side 6" Oak

Signed by: Craig W. McVean
 Surveyor's Michigan License No.: 39088

Date: 11/30/2005

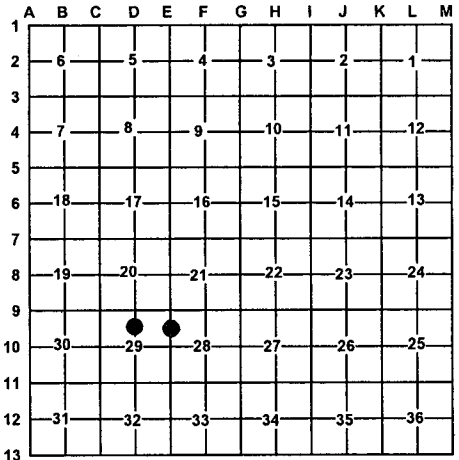

Register of Deeds Stamp & File Number