LAND CORNER RECORDATION CERTIFICATE

Filing Requirement of Act 74, Mich. PA 1970

For Corners In:
Arenac
(County)

		Located In			Corner Code #
1. Public Land Survey		T		R	
		T		R	
2. Property Controlling in Section	S 30	T 20N		R 3E	9
	S 30	T 20N		R 3E	12
3. Miscellaneous Property in Section	S	T		R	
	S	T		R	

Register of Deeds Stamp & File Number

4. Lot No: _____ Recorded Plat: _____

5. Private Claims: _____

I, Craig W. McVean, in a field survey on June 20, 2005 do hereby state that under requirements of PA 74, Michigan PA of 1970, the corner points mentioned in lines 1 and 2 above were in conformance with regulations and rules therefore as required in the current manual of survey instructions of the United States Department of the Interior, Bureau of Land Management or by a decree of a Court of Law and/or that the corner points mentioned in lines 3, 4 and 5 above were in conformance with the rules of the Michigan Board of Land Surveyors or by a Decree of a Court of Law; established, re-established, monumented, recovered, found as expressed below:

NOTE: Not more than 2 corners, all in the same town and range, may be recorded on this certificate.

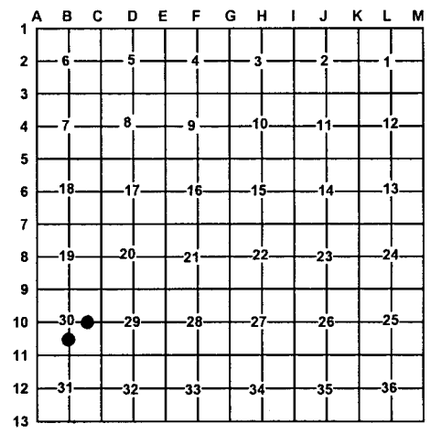

A. Description of original monument and accessories and/or subsequent restoration:

9 - None

12 - None

STATE OF MICHIGAN
CRAIG W. McVEAN
PROFESSIONAL SURVEYOR
No. 39088
LICENSED PROFESSIONAL SURVEYOR

B. Description of corner evidence found and/or method applied in restoring or re-establishing corner:

9 – CE 1/16 Cor., Sec. 30 – Set stamped 2" Alum. Cap on 5/8" x 48" iron rebar per Standard BLM procedure in swamp. E-W single strand is 3.5' N.

12 – CS 1/16 Cor., Sec. 30 – Set stamped 2" Alum. Cap on 5/8" x 34" iron rebar per Standard BLM procedure. NNW 69' to centerline of Gravel-Sand Rd. NE-SW. S16°W 74' to corner post of single strand S & E.

C. Description of monument for corner and accessories established to perpetuate locating the position of the corner:

9 – 2" Alum. Cap on 5/8" x 48" iron rebar.
Set Blue Carsonite Post with loc. tag 1' SW
S25°W 27.84' to set ½" x 24" rebar
S80°E 7.34' to set ½" x 9" rebar
N86°W 55.21' to set N & T in S. side Cedar fence post

12 – Set stamped 2" Aluminum Cap on 5/8" x 34" iron rebar
S50°W 2.06' to set N & T in N. side 15" R. Pine
N64°W 25.75' to set N & T in E. side 15" R. Pine
N3°E 20.37' to set N & T in SE side 14" R. Pine
S80°E 17.04' to set N & T in S. side 12" R. Pine
Set Blue Carsonite Post with loc. tag 1' NW

Signed by: Craig W. McVean Date: 11/30/2005

Surveyor's Michigan License No.: 39088

FORM APPROVED BY MICHIGAN STATE BOARD OF PROFESSIONAL SURVEYORS JAN. 28, 1971
Revised May 14, 1975
Revised Jan. 1983
Revised Oct. 1995