

# LAND CORNER RECORDATION CERTIFICATE

Filing Requirement of Act 74, Mich. PA 1970

For Corners In:  
Arenac Located In \_\_\_\_\_ Corner Code # \_\_\_\_\_  
 (County)

1. Public Land Survey	T	<u>20N</u>	R	<u>4E</u>	<u>K11</u>
	T	_____	R	_____	_____
2. Property Controlling in Section	S	T	R	_____	_____
	S	T	R	_____	_____
3. Miscellaneous Property in Section	S	T	R	_____	_____
	S	T	R	_____	_____

4. Lot No: \_\_\_\_\_ Recorded Plat: \_\_\_\_\_

5. Private Claims: \_\_\_\_\_

I, Craig W. McVean, in a field survey on August 2, 2001 do hereby state that under requirements of PA 74, Michigan PA of 1970, the corner points mentioned in lines 1 and 2 above were in conformance with regulations and rules therefore as required in the current manual of survey instructions of the United States Department of the Interior, Bureau of Land Management or by a decree of a Court of Law and/or that the corner points mentioned in lines 3, 4 and 5 above were in conformance with the rules of the Michigan Board of Land Surveyors or by a Decree of a Court of Law; established, re-established, monumented, recovered, found as expressed below:

**NOTE: Not more than 2 corners, all in the same town and range, may be recorded on this certificate.**

Register of Deeds Stamp & File Number

	A	B	C	D	E	F	G	H	I	J	K	L	M
1													
2	6		5		4		3		2		1		
3													
4	7		8		9		10		11		12		
5													
6	18		17		16		15		14		13		
7													
8	19		20		21		22		23		24		
9													
10	30		29		28		27		26		25		
11											●		
12	31		32		33		34		35		36		
13													

**A. Description of original monument and accessories and/or subsequent restoration:**


- |   |  |
|---|--|
| <p><u>K11</u> – GLO – Set post – J. Mullett – 1846<br/>                 Beech 14" S69°W 24 L.<br/>                 Beech 8" N42°E 22 L.</p> <p>- CSR – Lg. Bk., P. 13-14 – G.F. Carscallen - 1902<br/>                 Sec. 25 Survey</p> <p>- CSR – Bk. 6, P. 34 – 1907 – Fd. Post in Rd.<br/>                 Pine stub 30" N27 ½° W 1.29<br/>                 Pine St. 36" S57 ½°W 1.51</p> <p>- CSR – Bk. 16, P. 25 – Survey Sec. 36 - 1921</p> | <p>- MDOT – 1957 – Fd. 2" x 2" wood stake on N &amp; S Fen. Line.<br/>                 Set 1 ¼" iron bar; South 35.22' fen. Cor. post; North 30.87' fen. Cor. post; 4<sup>th</sup> fen. Post on E-W fen. Line S47°E 53.97'</p> <p>- Rec. Sur. – L. 2, P. 137 – R.L. Miller – 1995 - Fd. 1" pipe.</p> |
|---|--|

**B. Description of corner evidence found and/or method applies in restoring or re-establishing corner:**

K11 – Section cor. common to Sec. 25, 26, 35 & 36 – Fd. 1 ¼" x 24" long iron bar (axle shaft) per MDOT in CL of E-W. gravel Rd. in line w/ fences N & S. Co. Sur. Wits. are gone. 1 ¼" iron bar accepted as the best available evidence of the position of the original corner.

**C. Description of monument for corner and accessories established to perpetuate locating the position of the corner:**

K11 – Replaced 1 ¼" x 24" iron bar w/ 3" Arenac Co. Remon. Brass Cap on 5/8" x 34" Rebar w/ 4" x 1' PVC filled w/ conc. around cap – Down 0.5'.  
 S2°W 34.13' to set N & T in E side R.R. Tie fence post.  
 N37°E 53.76' to set N & T in NW side 13" R. Pine  
 S40°E 49.67' to set N & T in NE side 7" R. Pine  
 N65°W 38.56' to set ½" x 18" Rebar – Down 0.5'

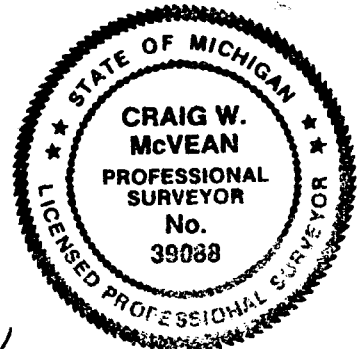

Signed by: Craig W. McVean  
 Surveyor's Michigan License No.: 39088

Date: 12/13/2001