

# LAND CORNER RECORDATION CERTIFICATE

## FILING REQUIREMENT OF ACT 74, MICH. P.A.1970

FOR CORNERS OF--:	LOCATED IN--:	CORNER CODE NUMBER
1. PUBLIC LAND SURVEY _____	T. <u>20</u> N. R. <u>5</u> E.	G-5; H-5; I-5
2. PROPERTY CONTROLLING IN SECTION _____	T. _____ N. S. R. _____ E. W.	_____
3. MISCELLANEOUS PROPERTY IN SECTION _____	T. _____ N. S. R. _____ E. W.	_____
4. LOT NO. _____, RECORDED PLAT _____		
5. PRIVATE CLAIMS _____		

REGISTER OF DEEDS STAMP AND FILING NUMBER

I, Kenneth J. Ostling, do hereby certify that under requirements of P.A. 74, Michigan P.A. of 1970, the corner points mentioned in lines 1 and 2 above were, in a field survey on January 12, 1978, established, re-established, monumented, re-monumented, recovered or restored as expressed below and in conformance with regulations and rules therefore as required in the current manual of survey instructions of the United States Department of the Interior, Bureau of Land Management or by a decree of a court of law. Furthermore, that the corner points mentioned in lines 3, 4 and 5 above were, in a field survey on \_\_\_\_\_, 19\_\_\_\_, found, recovered, restored, established or re-established as expressed below and in conformance with the rules of the Michigan State Board of Registration for Land Surveyors or, by a Decree of a Court of law:

A. Description of original monument and accessories and/or subsequent restoration:

B. Description of corner evidence found and/or method applied in restoring or re-establishing corner:

- G-5 Set 5/8" bar over magnetic attraction which falls in center of E-W road, in line with fences N & S.
- H-5 Found 1 1/4" iron bar about 1.0' S of centerline, in line with road north.
- I-5 Corner in  $\frac{1}{2}$  E-W road and in fence line north.

C. Description of monument for corner and accessories established to perpetuate locating the position of the corner:

G-5	H-5	
Set 5/8" Rod w/RLS Cap	Found 1 1/4" bar; raised w/1/2" Bar	Found 1/2" Bar & RLS Cap
3" S. Pine N29°E 58.9	Nail in 14" W. Pine S49°E 60.3	#16050
12" Ash S15°E 56.25	Nail in 12" R. Pine S37°W 64.36	Nail in 24" Maple
		S39°E 38.7
		Nail in 8" W. Pine
		S53°W 63.9

SIGNED BY Kenneth J. Ostling DATE 8/1/78

SURVEYOR'S MICHIGAN REGISTRATION NO. 10068

FOR STATE AND UNITED STATES AGENCIES.


SIGNED BY \_\_\_\_\_ DATE \_\_\_\_\_

CHIEF OF SURVEY PARTY

APPROVED AND SIGNED BY \_\_\_\_\_ DATE \_\_\_\_\_

MICHIGAN REGISTERED LAND SURVEYOR

(SEAL)

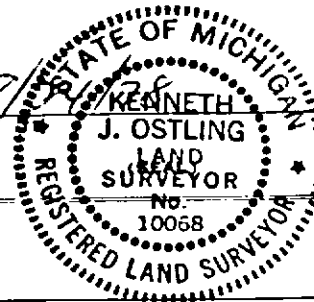

SURVEYOR'S MICHIGAN REGISTRATION NO. \_\_\_\_\_

ARENAC COUNTY