

LAND CORNER RECORDATION CERTIFICATE

FILING REQUIREMENT OF ACT 74, MICH. P.A.1970

FOR CORNERS OF--:	LOCATED IN--:	CORNER CODE NUMBER
1. PUBLIC LAND SURVEY _____	T. <u>20</u> N. R. <u>5</u> E.	<u>I-9; J-5; J-8</u>
2. PROPERTY CONTROLLING IN SECTION <u>22</u>	T. <u>20</u> N. R. <u>5</u> E.	<u>8</u>
3. MISCELLANEOUS PROPERTY IN SECTION _____	T. _____ N. S. R. _____ E. W.	_____
4. LOT NO. _____, RECORDED PLAT _____		
5. PRIVATE CLAIMS _____		

REGISTER OF DEEDS STAMP AND FILING NUMBER

I, Kenneth J. Ostling, do hereby certify that under requirements of P.A. 74, Michigan P.A. of 1970, the corner points mentioned in lines 1 and 2 above were, in a field survey on January 12, 1978, established, re-established, monumented, re-monumented, recovered or restored as expressed below and in conformance with regulations and rules therefore as required in the current manual of survey instructions of the United States Department of the Interior, Bureau of Land Management or by a decree of a court of law. Furthermore, that the corner points mentioned in lines 3, 4 and 5 above were, in a field survey on _____, 19____, found, recovered, restored, established or re-established as expressed below and in conformance with the rules of the Michigan State Board of Registration for Land Surveyors or, by a Decree of a Court of law:

A. Description of original monument and accessories and/or subsequent restoration:

B. Description of corner evidence found and/or method applied in restoring or re-establishing corner:


- I-9 Found ½" pipe in intersection N-S-E-W roads.
- J-5 Found ½" iron bar at intersection of N-S-E-W roads.
- J-8 Found ½" pipe in center N-S Co. road, in line fences E & W. Fits Co. Surveyor record for Sec. 22.
- 8 Set by standard survey procedure for subdivision of sections.

C. Description of monument for corner and accessories established to perpetuate locating the position of the corner:

I-9	J-5	J-8
Left ½" pipe in place	Fd. ½" rebar w/ RLS Cap #16050	Fd. ½" pipe; added RLS cap
Nail in PP S46°E 56.9	Nail in PP N33°E 85.2	Nail in 12" Birch S72°E 35.25
Nail in PP S60°W 57.45	Nail in PP S37°E 60.4	Nail in 6" Birch S32°E 37.15
8		
Set C, Spike in 10" Birch Stump		
7" W. Pine N07°W 29.2		
6" Cedar N77°W 23.7		

SIGNED BY Kenneth J. Ostling
 SURVEYOR'S MICHIGAN REGISTRATION NO. 10068

DATE 8/14/78

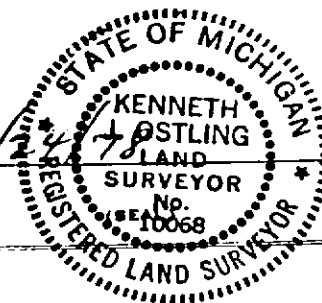

FOR STATE AND UNITED STATES AGENCIES:

SIGNED BY _____ DATE _____
CHIEF OF SURVEY PARTY

APPROVED AND SIGNED BY _____ DATE _____
MICHIGAN REGISTERED LAND SURVEYOR

(SEAL)

SURVEYOR'S MICHIGAN REGISTRATION NO. _____ ARENAC COUNTY

FORM APPROVED BY MICHIGAN STATE BOARD OF REGISTRATION, JAN. 28, 1971
 REVISED MAY 14, 1978

MAY PLACE SKETCH ON BACK OR ATTACHED SHEET