

LAND CORNER RECORDATION CERTIFICATE

Filing Requirement of Act 74, Mich. PA 1970

| | | | |
|--|---------------------------|---------------|--|
| For Corners In: <u>Arenac</u> (County) | Located In | Corner Code # | |
| 1. Public Land Survey | T <u>20N</u> R <u>05E</u> | <u>A9</u> | |
| | T <u>20N</u> R <u>04E</u> | <u>M9</u> | |
| 2. Property Controlling in Section | S _____ T _____ R _____ | _____ | |
| | S _____ T _____ R _____ | _____ | |
| 3. Miscellaneous Property in Section | S _____ T _____ R _____ | _____ | |
| | S _____ T _____ R _____ | _____ | |
| 4. Lot No: _____ | Recorded Plat: _____ | | |
| 5. Private Claims: _____ | | | |



DOC#: 201600533

201600533

February 29, 2016 10:45 AM

Darlene Mikkola
 Register of Deeds
 Arenac County, MI

Fee: \$14.00

Page 1 of 1 CD

RECORDS DIVISION

Register of Deeds Stamp & File Number

I, Joshua R. Davidson, in a field survey on January 15, 2015 do hereby state that under requirements of PA 74, Michigan PA of 1970, the corner points mentioned in lines 1 and 2 above were in conformance with regulations and rules therefore as required in the current manual of survey instructions of the United States Department of the Interior, Bureau of Land Management or by a decree of a Court of Law and/or that the corner points mentioned in lines 3, 4 and 5 above were in conformance with the rules of the Michigan Board of Land Surveyors or by a Decree of a Court of Law; established, re-established, monumented, recovered, found as expressed below:

NOTE: Not more than 2 corners, all in the same town and range, may be recorded on this certificate.

| | | | | | | | | | | | | | |
|----|----|---|----|---|----|---|----|---|----|---|----|---|---|
| | A | B | C | D | E | F | G | H | I | J | K | L | M |
| 1 | | | | | | | | | | | | | |
| 2 | 6 | | 5 | | 4 | | 3 | | 2 | | 1 | | |
| 3 | | | | | | | | | | | | | |
| 4 | 7 | | 8 | | 9 | | 10 | | 11 | | 12 | | |
| 5 | | | | | | | | | | | | | |
| 6 | 18 | | 17 | | 16 | | 15 | | 14 | | 13 | | |
| 7 | | | | | | | | | | | | | |
| 8 | 19 | | 20 | | 21 | | 22 | | 23 | | 24 | | |
| 9 | ● | | | | | | | | | | | | ● |
| 10 | 30 | | 29 | | 28 | | 27 | | 26 | | 25 | | |
| 11 | | | | | | | | | | | | | |
| 12 | 31 | | 32 | | 33 | | 34 | | 35 | | 36 | | |
| 13 | | | | | | | | | | | | | |

A. Description of original monument and accessories and/or subsequent restoration:

A9 – M9 – corner common to sections 19 & 30, T20N, R5E and sections 24 & 25, T20N, R4E

- 1837 – GLO – L. Clason – set sec post corner of 24 & 25 –
 1) Hemlock 15" S87°W 8; 2) Hemlock 24" N41°W 60.
- 1846 – GLO – B. F. Hall – set sec post corner of 24 & 25 –
 3) Hemlock 16" S87°E 27; 4) Sugar 16" N34°E 31.
- 1957 – MDOT Survey notes – found 3/8" X 6" bolt set 1 3/4" iron bar – 5) P.P. S52°W 67.41'; 6) Steel sign post N45°E 42.18'; 7) 17" Maple S50°E 43.18'.
- 1983 – Certificate of Survey L. 1, P.491 – R. Miller, PS # 16050 – 8) S45°W 64.77' P.P.; 9) N45°E 44.50' St. sign; 10) N45°W 45.0' tel box; 11) S25°E 65.45' St. sign.

B. Description of corner evidence found and/or method applied in restoring or re-establishing corner:


A9 – M9 – corner common to sections 19 & 30, T20N, R5E and sections 24 & 25, T20N, R4E

Found railroad spike in monument box in centerline road intersection. Distance South to A10/M10 measures 2628.61'-grid compares to 2628.94'-MDOT, and 2628.54'-Miller. Accepted found railroad spike in monument box at the best available evidence of the position of the original corner.

C. Description of monument for corner and accessories established to perpetuate locating the position of the corner:

A9 – M9 – railroad spike in monument box

- N48°E 50.34' to found nail & tag in NW. side fence post
- S77°E 150.37' to set nail & tag in S. side 19" Elm
- S14°E 104.72' to found nail in W. side 10" W. Pine
- S52°W 65.13' to MSHD nail & tag in NW. side P. Pole
- N65°W 82.36' to found nail in power pole (#6)

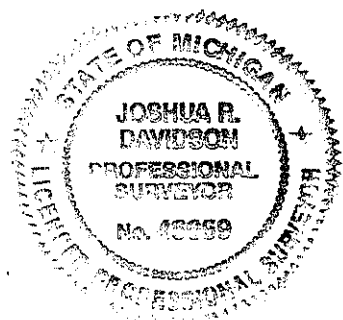

Signed by: *Joshua R. Davidson*
 Surveyor's Michigan License No.: 46659

Date: February 24, 2016