

LAND CORNER RECORDATION CERTIFICATE

FILING REQUIREMENT OF ACT 74, MICH. P.A. 1970

FOR CORNERS OF--:	LOCATED IN--:	CORNER CODE NUMBER
1. PUBLIC LAND SURVEY_____	T. <u>20</u> N. <u>7</u> E. <u>W</u> S. <u>W</u> R. <u>7</u>	G-1, I-1, K-1
2. PROPERTY CONTROLLING IN SECTION <u>2</u>	, T. <u>20</u> N. <u>7</u> E. <u>W</u> S. <u>W</u> R. <u>7</u>	Code 1
3. MISCELLANEOUS PROPERTY IN SECTION _____	, T. _____ N. _____ E. _____ S. _____ R. _____ W. _____	
4. LOT NO. _____, RECORDED PLAT _____		
5. PRIVATE CLAIMS _____		

REGISTER OF DEEDS STAMP AND FILING NUMBER

I, Kenneth J. Ostling do hereby certify that under requirements of P.A. 74, Michigan P.A. of 1970, the corner points mentioned in lines 1 and 2 above (identified with circles on index code diagram—over) were, in a field survey on 5-14-73 19___, established, re-established, monumented, re-monumented, recovered or restored as expressed below and in conformance with regulations and rules therefore as required in the current manual of survey instructions of the United States Department of the Interior, Bureau of Land Management or by a decree of a court of law. Furthermore, that the corner points mentioned in lines 3, 4 and 5 above were, in a field survey on _____ 19___, found, recovered, restored, established or re-established as expressed below and in conformance with the rules of the Michigan State Board of Registration for Land Surveyors or, by a Decree of a Court of law:

A. Description of original monument and accessories and/or subsequent restoration:

B. Description of corner evidence found and/or method applied in restoring or re-establishing corner:

- G-1 Set corner from what we conclude to be old NBT of record by 1908 County surveyor. Fits recorded measurement East to corner 31-32
- I-1 Set this corner by proportionate measurement between section corner East and 1/4 corner West, compared to the 1908 survey of record. Could locate no previous corner.
- K-1 Set by proportionate measurement to 1908 survey record. Previous corner obliterated by ditches and dikes.
- Code 1 Set by proportionate measurement between section and 1/4 corner to mark prop. boundary.

C. Description of monument for corner and accessories established to perpetuate locating the position of the corner:

G-1	I-1	K-1
Set DNR Monument	Set DNR Monument	Set DNR Monument
8" Bl. Ash N05E 9.0'	15" S. Maple S45W 8.0'	16" Ash N87W 49.2'
11" " " S80W 13.7'	22" S. Maple S28E 23.0'	20" Ash S11E 67.9'
9" Maple N52W 22.8'		
		Code 1
		Set 1"x36" pipe
		5" Maple S57E 7.7'
		3" Maple S10W 10.3'


SIGNED BY Kenneth J. Ostling DATE _____

SURVEYOR'S MICHIGAN REGISTRATION NO. 10068

FOR STATE AND UNITED STATES AGENCIES:

SIGNED BY _____ DATE _____
CHIEF OF SURVEY PARTY

APPROVED AND SIGNED BY _____ DATE _____
MICHIGAN REGISTERED LAND SURVEYOR (SEAL)

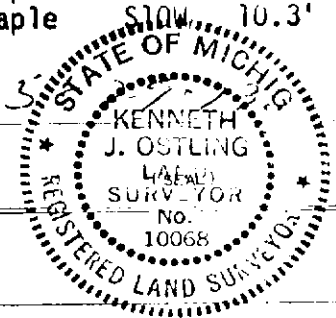

SURVEYOR'S MICHIGAN REGISTRATION NO. _____