


**LAND CORNER RECORDATION CERTIFICATE**  
**Filing Requirement of Act 74, Mich. P.A. 1970**

For corners in

<u>Baraga</u> (County)	Located In:	Corner Code #
1. Public Land Survey	T <u>47N</u> R <u>33W</u>	<u>A5</u>
	T <u>47N</u> R <u>33W</u>	<u>E4</u>
	T _____ R _____	_____
	T _____ R _____	_____
2. Property Controlling in Section	S _____ T _____ R _____	_____
	S _____ T _____ R _____	_____
3. Miscellaneous Property in Sec.	S _____ T _____ R _____	_____
	S _____ T _____ R _____	_____

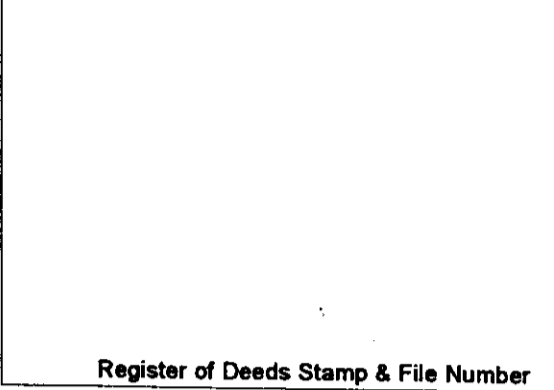


4. Lot No. \_\_\_\_\_, Recorded Plat \_\_\_\_\_  
 5. Private Claims \_\_\_\_\_

E4 Jun 23 2003  
 A5 Jun 25 2003

I, Stephan J. Szyszkoski, in a field survey on \_\_\_\_\_, 20\_\_\_\_ do hereby state that under requirements of P.A. 74, Michigan P.A. of 1970, the corner points mentioned in lines 1 and 2 above were in conformance with regulations and rules therefore as required in the current manual of survey instructions of the United States Department of the Interior, Bureau of Land Management or by a decree of a Court of Law and /or that the corner points mentioned in lines 3, 4 and 5 above were in conformance with the rules of the Michigan Board of Land Surveyors or by a Decree of a Court of Law; established, re-established, monumented, recovered, found as expressed below:

**NOTE:** Not more than 2 corners, all in the same town and range, may be recorded on this certificate.

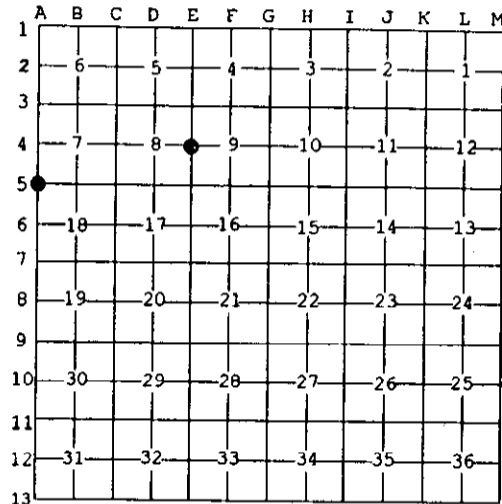

**A. Description of original monument and accessories and/or subsequent restoration:**

- (A5) Corner common to Sections 7-18 T47N-R33W and 12-13 T47N-R34W. 1979: Keith Sackett, RLS restored the corner "by land calls in 4 directions. Fits good with other corners in area". Set 1"IDx36" I.pipe. 6" Sugar S27W 28.8', 7" Sugar S78E 28.2', 14" Maple N80W 42.5'.
- (E4) Quarter corner common to Sections 8-9. 1852: Established by Francis Houck: S3'W Corrected btwn Secs. 8&9...40.00 Set qr post. Fir 8 N21W 18 links, Y.Birch 10 S62E 43 links.

**B. Description of corner evidence found and/or method applied in restoring or reestablishing corner:**

- (A5) Recovered the 1979 monument in good condition and at record bearing and distance from the remaining NBT Sugar SW, in good condition. The other NBTs have been removed. Left the monument in place and made new witnesses as described below.
- (E4) The original post was not recovered. Found possible original BT Y.Birch with overgrown scars but too far decayed to locate any scribing. Distance north to reestablished corner is 2630.79' (2640 GLO), agreeing well with indexed distances observed on other lines in the NW part of the township. I accepted the Y.Birch as the original BT and monumented the corner at record bearing and distance N62W, 43 links distant. There was no sign of the Fir BT.

**C. Description of monument for corner and accessories established to perpetuate locating the position of the corner:**

- |   |   |
|---|---|
| (A5) Found 1"ID I.pipe with 4" alum. MDNR cap. Blazed, scribed, and set measuring nails in: | (E4) Set 1/2" dia. rebar grouted into drilled hole over which grouted a 1"IDx8" I.pipe with 4" alum. MDNR cap. Blazed, scribed, and set nails in: |
| 5" Sugar N63W 17.6'      "S12 N8T"  | 12" Sugar N59E 8.64'      "1/4S NBT"  |
| 5" Sugar N80E 16.8'      "S7 NBT"   | 12" Sugar S31E 4.60'      do  |
| 5" Sugar S60E 17.5'      "S18 NBT"  | 8" Sugar S60W 45.0'      do   |
| 9" Sugar S26W 28.9' the 1979 NBT  | 7" Sugar N17W 39.0'      do   |
| Bearings are magnetic. Distances are to nail with tag. Placed sq'd cedar post adjacent.     | Bearings are magnetic. Distances to nail with tag. Set sq'd Y.Birch post N17W 2.4' distant.   |



Signed by Stephan J. Szyszkoski Date 7/16/03  
 Surveyor's Michigan License No. 33986