

**LAND CORNER RECORDATION CERTIFICATE**  
**Filing Requirement of Act 74, Mich. P.A. 1970**

For corners in

<u>Baraga</u> (County)	Located in:	Corner Code #
1. Public Land Survey	T <u>47N</u> R <u>33W</u>	<u>82</u>
	T <u>   </u> R <u>   </u>	<u>   </u>
	T <u>   </u> R <u>   </u>	<u>   </u>
	T <u>   </u> R <u>   </u>	<u>   </u>
2. Property Controlling in Section	S <u>6</u> T <u>47N</u> R <u>33W</u>	<u>8</u>
	S <u>   </u> T <u>   </u> R <u>   </u>	<u>   </u>
3. Miscellaneous Property in Sec.	S <u>   </u> T <u>   </u> R <u>   </u>	<u>   </u>
	S <u>   </u> T <u>   </u> R <u>   </u>	<u>   </u>

Register of Deeds Stamp & File Number

4. Lot No. \_\_\_\_\_, Recorded Plat \_\_\_\_\_  
 5. Private Claims \_\_\_\_\_

Jun 16 2003

I, Stephan J. Szyszkoski, in a field survey on \_\_\_\_\_, 20\_\_ do hereby state that under requirements of P.A. 74, Michigan P.A. of 1970, the corner points mentioned in lines 1 and 2 above were in conformance with regulations and rules therefore as required in the current manual of survey instructions of the United States Department of the Interior, Bureau of Land Management or by a decree of a Court of Law and /or that the corner points mentioned in lines 3, 4 and 5 above were in conformance with the rules of the Michigan Board of Land Surveyors or by a Decree of a Court of Law; established, re-established, monumented, recovered, found as expressed below:

**NOTE:** Not more than 2 corners, all in the same town and range, may be recorded on this certificate.

1	A	B	C	D	E	F	G	H	I	J	K	L	M
2	●	●		5		4		3		2		1	
3													
4	7		8		9		10		11		12		
5													
6	19		17		16		15		14		13		
7													
8	19		20		21		22		23		24		
9													
10	30		29		28		27		26		25		
11													
12	31		32		33		34		35		36		
13													

A. Description of original monument and accessories and/or subsequent restoration:  
 (82) Center of Section 6. Not established in the original survey.  
 (8-Sec. 6) West 1/16 corner, Section 6. Not established in the original survey.

B. Description of corner evidence found and/or method applied in restoring or reestablishing corner:

(82) Established the corner at the intersection of straight lines connecting opposite 1/4 corners. The position for the corner falls in the roots of a dead and submerged cedar. The monument was made firm in a mound of rock, largely submerged.  
 (8-Sec. 6) Established the corner on a straight line between Center of Section 1318.84' East and 1/4 corner 1167.17' West, being 20 chains proportioned to the mean record distance 37.70 chains, west of the Center.

C. Description of monument for corner and accessories established to perpetuate locating the position of the corner:

(82) Set 1"IDx32" I.pipe with 4" alum. MDNR cap. Blazed, scribed, and set measuring nails in:


11" Cedar N59W 67.1'      "C1/4 BT"  
 5" Cedar N16W 7.9'      do  
 3" Balsam East 6.1'      do  
 3" Balsam S68E 8.3'      do

Set sq'd cedar post adjacent. Bearings are magnetic. Distances are to nail with tag.

(8) Set 1"IDx32" I.pipe with 4" alum. MDNR cap. Blazed, scribed, and set measuring nails in:

6" Sugar N23W 6.3'      "1/16S BT"  
 7" Sugar S47E 10.8'      do  
 5" Sugar S40W 12.1'      do  
 10" Maple N84W 23.7'      do

Set sq'd cedar post adjacent. Bearings are magnetic. Distances are to nail with tag.

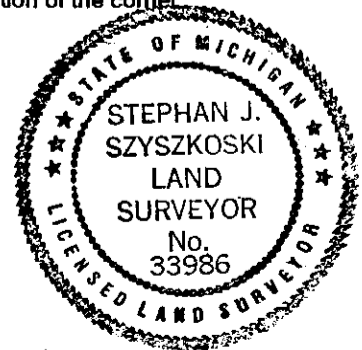

Signed by Stephan J. Szyszkoski  
 Surveyor's Michigan License No. 33986

Date 7/16/03