

**LAND CORNER RECORDATION CERTIFICATE**  
**Filing Requirement of Act 74, Mich. P.A. 1970**

For corners in

Baraga	Located In:	Corner Code #
(County)		
1. Public Land Survey	T <u>47N</u> R <u>33W</u>	<u>C3</u>
	T <u>47N</u> R <u>33W</u>	<u>C2</u>
	T _____ R _____	_____
	T _____ R _____	_____
	T _____ R _____	_____
2. Property Controlling in Section	S _____ T _____ R _____	_____
	S _____ T _____ R _____	_____
3. Miscellaneous Property in Sec.	S _____ T _____ R _____	_____
	S _____ T _____ R _____	_____

Register of Deeds Stamp & File Number

4. Lot No. \_\_\_\_\_, Recorded Plat \_\_\_\_\_  
 5. Private Claims \_\_\_\_\_

May 20 2003

I, Stephan J. Szyszkoski, in a field survey on \_\_\_\_\_, 20\_\_\_\_ do hereby state that under requirements of P.A. 74, Michigan P.A. of 1970, the corner points mentioned in lines 1 and 2 above were in conformance with regulations and rules therefore as required in the current manual of survey instructions of the United States Department of the Interior, Bureau of Land Management or by a decree of a Court of Law and /or that the corner points mentioned in lines 3, 4 and 5 above were in conformance with the rules of the Michigan Board of Land Surveyors or by a Decree of a Court of Law, established, re-established, monumented, recovered, found as expressed below:

**NOTE: Not more than 2 corners, all in the same town and range, may be recorded on this certificate.**

1	A	B	C	D	E	F	G	H	I	J	K	L	M
2	6	•	5		4		3		2		1		
3		•											
4	7		8		9		10		11		12		
5													
6	18		17		16		15		14		13		
7													
8	19		20		21		22		23		24		
9													
10	30		29		28		27		26		25		
11													
12	31		32		33		34		35		36		
13													

**A. Description of original monument and accessories and/or subsequent restoration:**

(C3) Corner common to Sections 5-6-7-8. 1852: Established by Francis Houck: S2'E corrected between Secs. 5 & 6...79.21 corner of Secs. 5-6-7-8. Y. Birch 16 N45W 36 links, Y. Birch 14 S39E 44 links.

(C2) Quarter corner common to Sections 5-6. 1852: Established by Francis Houck: S2'E corrected between Sections 5 & 6...39.21 Set qr Post. Fir 8 N36 1/2 W 39 links, Cedar 12 S45E 38 links...79.21 Corner of Sections 5-6-7-8.

**B. Description of corner evidence found and/or method applied in restoring or reestablishing corner:**

(C3) The original post and accessories were not recovered. Reestablished the corner by double proportionate measurement between original corners 2630.48' West (40.00 ch. GLO), and 5256.14' South (80.00 ch. GLO), and reestablished corners 5204.34' North (79.21 ch. GLO), and 5278.72' East (80.27 ch. GLO).

(C2) The original post and accessories were not recovered. Reestablished the corner on a line of mean true bearing between section corners 2628.13' south and 2576.22' north, being the proportionate position.

**C. Description of monument for corner and accessories established to perpetuate locating the position of the corner:**

(C3) Set 1"IDx32" I.pipe with 4" alum. MDNR cap. Blazed, scribed, and set measuring nails in:


- 13" Y.Birch N85E 1.7'      "S5 NBT"
- 15" Sugar S33E 38.2'      "S8 NBT"
- 14" Sugar S05W 39.4'      "S7 NBT"
- 20" Y.Birch S75W 42.4'      do

Placed a sq'd cedar post adjacent. Bearings are magnetic. Distances are to nail with tag.

(C2) Set 1"IDx32" I.pipe with 4" alum. MDNR cap. Blazed, scribed, and set measuring nails in:

- 12" Sugar N02W 27.1'      "1/4S NBT"
- 7" Sugar S55E 17.8'      do
- 7" Sugar S04E 20.2'      do
- 10" Sugar N38W 34.3'      do

Set sq'd cedar post adjacent. Bearings are magnetic. Distances are to nail with tag.

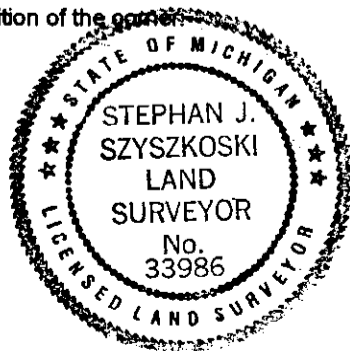

Signed by Stephan J. Szyszkoski  
 Surveyor's Michigan License No. 33986

Date 7/16/03