


LAND CORNER RECORDATION CERTIFICATE
Filing Requirement of Act 74, Mich. P.A. 1970

For corners in

<u>Baraga</u> (County)	Located In:	Corner Code #
1. Public Land Survey	T <u>47N</u> R <u>33W</u>	<u>B1</u>
	T <u>47N</u> R <u>33W</u>	<u>D3</u>
	T _____ R _____	_____
	T _____ R _____	_____
2. Property Controlling in Section	S _____ T _____ R _____	_____
	S _____ T _____ R _____	_____
3. Miscellaneous Property in Sec.	S _____ T _____ R _____	_____
	S _____ T _____ R _____	_____

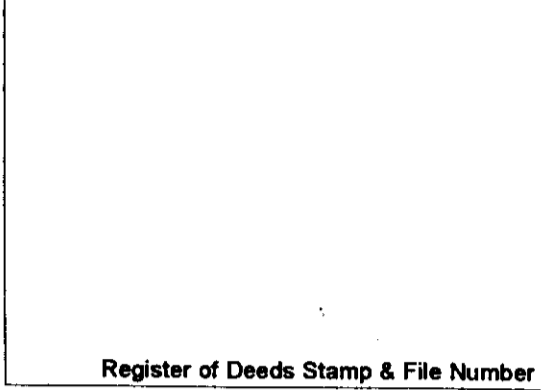

4. Lot No. _____, Recorded Plat _____
5. Private Claims _____

D3 May 20 2003
B1 Mar 06 2003

I, Stephan J. Szyszkoski, in a field survey on _____, 20____ do hereby state that under requirements of P.A. 74, Michigan P.A. of 1970, the corner points mentioned in lines 1 and 2 above were in conformance with regulations and rules therefore as required in the current manual of survey instructions of the United States Department of the Interior, Bureau of Land Management or by a decree of a Court of Law and/or that the corner points mentioned in lines 3, 4 and 5 above were in conformance with the rules of the Michigan Board of Land Surveyors or by a Decree of a Court of Law; established, re-established, monumented, recovered, found as expressed below:

NOTE: Not more than 2 corners, all in the same town and range, may be recorded on this certificate.

A	B	C	D	E	F	G	H	I	J	K	L	M
1	●											
2	6		5		4		3		2		1	
3			●									
4	7		8		9		10		11		12	
5												
6	18		17		16		15		14		13	
7												
8	19		20		21		22		23		24	
9												
10	30		29		28		27		26		25	
11												
12	31		32		33		34		35		36	
13												

A. Description of original monument and accessories and/or subsequent restoration:


- (B1) Quarter corner common to Section 6 T47N-R33W and Section 31 T48N-R33W. 1846: Established by Austin Burt: West on South side of Section 31...40.00 Set Fir post Qr. Section corner. Fir 11 N59E 12, Spruce 14 N60W 42...77.47 Intersected Range line.
- (D3) Quarter corner common to Sections 5 and 8. 1852: Established by Francis Houck: N89 deg 43'W corrected between Secs. 5 & 8...40.135 Set qr post. Spruce 8 N65E 14 links, Fir 10 S64W 19 links... 80.27 Sect. Corner.

B. Description of corner evidence found and/or method applied in restoring or reestablishing corner:

- (B1) The original post and accessories were not recovered. Found no acceptable evidence of the position of the original corner on the ground. Reestablished the corner on the latitudinal township line between Section corners 2648.70' East and 2481.17' West, being the proportionate position.
- (D3) The original post and accessories were not recovered. Reestablished the corner midway and on a line of mean true bearing between Section corners 2639.36' East and West. The mean true bearing of the Section line was observed to be N 89 deg 35'W.

C. Description of monument for corner and accessories established to perpetuate locating the position of the corner:

- | | |
|--|---|
| (B1) Set 1"IDx32" Iron pipe with 4" alum. MDNR cap. Blazed, scribed, and set measuring nails in: | (D3) Set 1"IDx32" I.pipe with 4" alum. MDNR cap. Blazed, scribed, and set measuring nails in: |
| 16" Maple N41E 3.7' "1/4S N8T" | 9" B.Spruce N17E 18.6' "1/4S N8T" |
| 8" N.Spruce S48E 52.75' do | 10" B.Spruce S76E 7.8' do |
| 12" Y.Birch S32W 32.5' do | 12" Cedar S06E 16.4' do |
| 7" Y.Birch N65W 6.2' do | 9" Cedar N75W 30.1' do |
- Bearings are magnetic. Distances are to nail with tag. Squared a 2" Sugar N60E 0.5' distant.
- Bearings are magnetic. Distances are to nail with tag. Placed a squared cedar post adjacent.

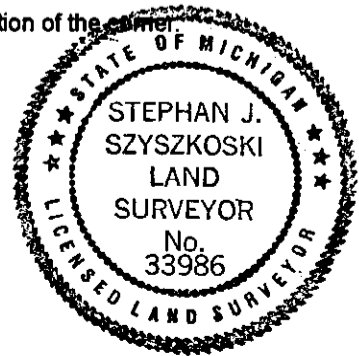

Signed by Stephan J. Szyszkoski
Surveyor's Michigan License No. 33986

Date 7/16/03