

**LAND CORNER RECORDATION CERTIFICATE**  
**Filing Requirement of Act 74, Mich. P.A. 1970 as Amended**


For corners in

<u>Baraga</u> (County)	Located In:	Corner Code #
1. Public Land Survey	T 47N R 33W	K13
	T 46N R 33W	K1 in Iron Co.
	T _____ R _____	(same corner)
2. Property Controlling in Section	S _____ T _____ R _____	_____
	S _____ T _____ R _____	_____
	S _____ T _____ R _____	_____
3. Miscellaneous Property in Sec.	S _____ T _____ R _____	_____
	S _____ T _____ R _____	_____
4. Lot No. _____, Recorded Plat _____		
5. Private Claims _____		

Register of Deeds Stamp & File Number

--	--	--	--	--	--	--	--	--	--	--	--	--	--	--

I, Stephan J. Szyszkoski, in a field survey on 02/24/2009 do hereby state that under requirements of P.A. 74, Michigan P.A. of 1970, the corner points mentioned in lines 1 and 2 above were in conformance with regulations and rules therefore as required in the current manual of survey instructions of the United States Department of the Interior, Bureau of Land Management or by a decree of a Court of Law and /or that the corner points mentioned in lines 3, 4 and 5 above were in conformance with the rules of the Michigan Board of Land Surveyors or by a Decree of a Court of Law; established, re-established, monumented, recovered, found as expressed below:

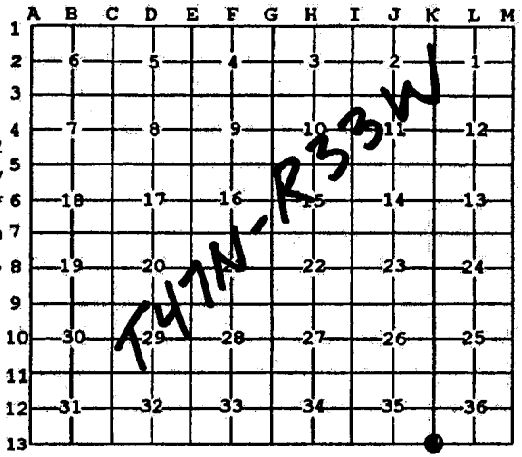

NOTE: Not more than 2 corners, all in the same town and range, may be recorded on this certificate.

A. Description of original monument and accessories and/or subsequent restoration:

(K13) Section corner common to 35-36 T47N-R33W and 1-2 T46N-R33W. 1846 - Established by Austin Burt Deputy Surveyor. Set Spruce post. Tamarac 7" N43E 21 links, Tamarac 12" N32W 26 links. 1852 - Francis Houck Deputy Surveyor marked Cedar 8" S52 1/2W 8 links, Cedar 10" S71E 17 links. 1954 - D.L.Buell and H.E.Gerry for Northern Paper Mills found "Tam NE as a stub, I.M. plain; Tam NW as a rotted stump, no I.M.; Cedar SW as a 12" tree, nearly dead, I.M. very plain; Ced. SE as a down tree with faces, no I.M. Found top of original post. Set pipe from Tam. NW and Ced. SW. Cut two new B.T. Ced. 8" N42W 26 and Ced 10" S45E 48. Set Iron pipe and Brass cap".

B. Description of corner evidence found and/or method applied in restoring or reestablishing corner:

(K13) Found the 1954 NPM iron pipe and brass cap monument disturbed but still at approximate corner position. Found the original Tam. BT 7" N43E 21, a dead stub about 8' high with scribing plain. Found the 1954 NBT Cedar 8" N42W 26 links in good condition. Found an ice-covered void in the moss at record distance from both of these trees and remonumented this position.

C. Description of monument for corner and accessories established to perpetuate locating the position of the corner:

(K13) Set 1"IDx60" I.pipe with 4" alum. MDNR cap made firm with 2-36" long cedar pickets. Set measuring nail with MDNR tag in the side of:  
 7" Cedar N53E 11.5' mrkd "S36 NBT"  
 8" Cedar S70E 12.7' "S1 NBT"  
 10" Cedar S04E 7.9' "S1 NBT"  
 5" Cedar S71W 7.0' "S2 NBT"  
 Set sq'd cedar post adjacent.  
 Bearings are magnetic.



Signed by Stephan J. Szyszkoski Date 10/06/2009  
 Surveyor's Michigan License No. 33986