

# LAND CORNER RECORDATION CERTIFICATE

## FILING REQUIREMENT OF ACT 74, MICH. P.A. 1970

| FOR CORNERS OF--                            | LOCATED IN--                            | CORNER CODE NUMBER |
|---|---|--------------------|
| 1. PUBLIC LAND SURVEY _____                 | T. <u>47</u> N. S. R. <u>34</u> E. W.   | F3                 |
| 2. PROPERTY CONTROLLING IN SECTION <u>4</u> | , T. <u>47</u> N. S. R. <u>34</u> E. W. | 15 & 16            |
| 3. MISCELLANEOUS PROPERTY IN SECTION _____  | , T. _____ N. S. R. _____ E. W.         |                    |
| 4. LOT NO. _____, RECORDED PLAT _____       |   |                    |
| 5. PRIVATE CLAIMS _____                     |   |                    |

REGISTER OF DEEDS STAMP AND FILING NUMBER

I, Arthur O. Enger do hereby certify that under requirements of P.A. 74, Michigan P.A. of 1970, the corner points mentioned in lines 1 and 2 above (identified with circles on index code diagram - over) were, in a field survey on July 15, 1974, established, re-established, monumented, re-monumented, recovered or restored as expressed below and in conformance with regulations and rules therefore as required in the current manual of survey instructions of the United States Department of the Interior, Bureau of Land Management or by a decree of a court of law. Furthermore, that the corner points mentioned in lines 3, 4 and 5 above were, in a field survey on \_\_\_\_\_ 19\_\_\_\_, found, recovered, restored, established or re-established as expressed below and in conformance with the rules of the Michigan State Board of Registration for Land Surveyors or, by a Decree of a Court of law:

**A. Description of original monument and accessories and/or subsequent restoration:**

**Corner F3:** Found no evidence of original post or its accessories or of any replacement monuments or accessories.

**Corner 15 & 16:** Not established in original survey nor subsequently, apparently.

**B. Description of corner evidence found and/or method applied in restoring or re-establishing corner:**

**Corner F3:** Re-established on line between Sec. Cor. 40.569 ch. to E and to W. Found a 3"x3"x4' squared post S73E .419 ch. set by unknown persons for an approximate corner.

**Corner 15:** Established on line between Sec. Cor. 20.285 ch. W and 1/4 cor. 20.285 ch. E.

**Corner 16:** Established on line between Sec. Cor. 20.285 ch. E and 1/4 cor. 20.285 ch. W.

**C. Description of monument for corner and accessories established to perpetuate locating the position of the corner:**

Monuments for all three corners: 1" I.D. x 36" iron pipe with 3 1/2" aluminum cap.

Witnesses for Corner F3: B. Spruce 4 N29°E (mag.) 18.1 ft. "1/4S, NBT"  
B. Spruce 4 S41°W (mag.) 27.5 ft. "1/4S, NBT"

Witnesses for Corner 15: Cedar 6 S26°W (mag.) 11.9 ft. "1/16S, BT"  
Cedar 8 N26°E (mag.) 22.9 ft. "1/16S, BT"

Witnesses for Corner 16: W. Spruce 18 S65°E (mag.) 37.8 ft. "1/16S, BT"  
W. Pine 28 N6°W (mag.) 22.9 ft. "1/16S, BT"

SIGNED BY \_\_\_\_\_ DATE \_\_\_\_\_

SURVEYOR'S MICHIGAN REGISTRATION NO. \_\_\_\_\_

(SEAL)

FOR STATE AND UNITED STATES AGENCIES:

SIGNED BY \_\_\_\_\_ DATE \_\_\_\_\_

APPROVED AND SIGNED BY Arthur O. Enger DATE September 23, 1975

Arthur O. Enger  
Michigan Registered Land Surveyor


Michigan Department of Natural Resources



SURVEYOR'S MICHIGAN REGISTRATION NO. 13581


**CORNER NUMBERING CODE DIAGRAMS FOR IDENTIFYING LAND CORNER RECORDATIONS AND INDEXING**

**FOR PUBLIC LAND SURVEY CORNERS IN THE  
T. 47N, R. 34W (MENTIONED OVER)**

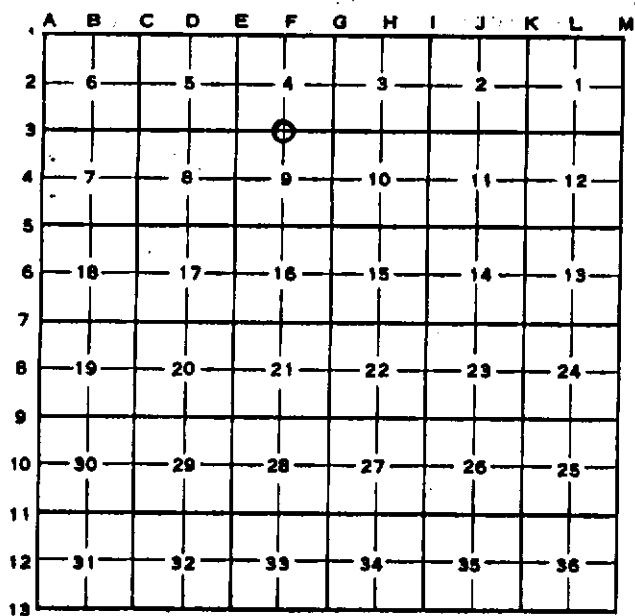

Apply letter prefix for corner points encircled above for identifying corner recordation numbers over.

**FOR PROPERTY CONTROLLING AND MISC. PROPERTY CORNERS WITHIN THE SECTION (MENTIONED OVER AND EXCLUDE LOT CORNER)**

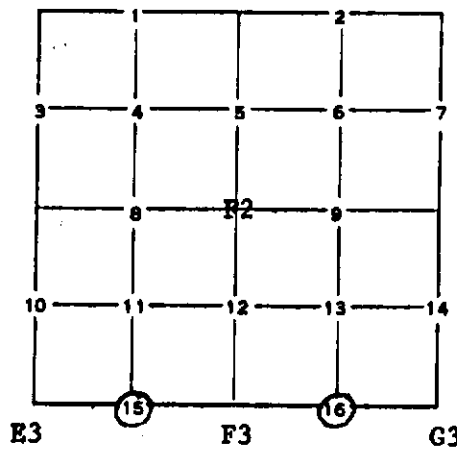

1. Above coded numbers are positioned on 1/16 fractional lines of the section.
2. Township corner code numbers shall be applied to corners of above typical section not numbered.
3. Miscellaneous property corners within a section, located at points other than numbered above, shall be referenced to at least two of above corner code numbers.
4. Private claim corners to be tied to rectangular land corners if possible - sketch required below.

**EXPLANATORY SKETCH IF NECESSARY -- BELOW**

