

MICHIGAN  
DEPARTMENT OF CONSERVATION  
FORESTRY DIVISION

# LAND CORNER RECORD

T. 47 N.R. 34W


Baraga COUNTY

DESCRIPTION OF CORNER Sec. Cor. common to Sections 17, 18, 19, 20

CORNER MONUMENT 1" pipe with 4" aluminum cap

DATE MONUMENT PLACED AND WITNESSED October 26, 1966

WITNESSES TO CORNER..... 5" Hard Maple (S19 NBT) S24°W 12.5'

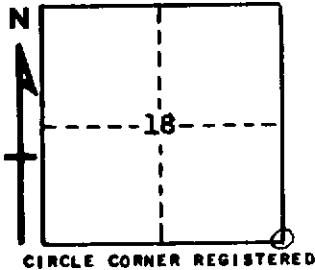

5" Hard Maple (S20 NBT) S64°E 21.2'

6" Soft Maple (S17 NBT) N33°E 10.8'

AND

DESCRIPTION IN DETAIL AS TO HOW CORNER WAS LOCATED AND IDENTIFIED OR RESTORED.

This corner placed at a 12" cedar, squared prior to 1941, by Ford Motor Company surveyors. Several signatures and dates are evident.

SURVEYOR'S SEAL

SIGNED Billy D. Buckler DATE 3/20/89.  
REGISTERED LAND SURVEYOR