

MICHIGAN
DEPARTMENT OF CONSERVATION
FORESTRY DIVISION

LAND CORNER RECORD

T. 47 N.R. 34W


Baraga COUNTY

DESCRIPTION OF CORNER 1/4 Cor. bet. Secs. 8-9

CORNER MONUMENT 1" pipe with 4" aluminum cap.

DATE MONUMENT PLACED AND WITNESSED 3/8/66

WITNESSES TO CORNER..... 16" Hard Maple (1/4 S NBT) S75°W, 19.8'

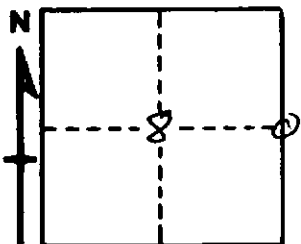

15" Hard Maple (1/4 S NBT) S64°E, 48.0'

AND

CIRCLE CORNER REGISTERED

DESCRIPTION IN DETAIL AS TO HOW CORNER WAS LOCATED AND IDENTIFIED OR RESTORED.

This corner re-established on line and 8.70 chs. south of a 32" W. Pine,
a probable line tree.

Cor. lies 35 lks. west of a woods road.

SURVEYOR'S SEAL

SIGNED Billy D. Buckler DATE 2/8/67
REGISTERED LAND SURVEYOR