

MICHIGAN
DEPARTMENT OF CONSERVATION
FORESTRY DIVISION

LAND CORNER RECORD

T. 47 N.R. 34W


Baraga COUNTY

DESCRIPTION OF CORNER 1/2 cor. bet. secs. 9-10

CORNER MONUMENT 1" pipe with 4" aluminum cap.

DATE MONUMENT PLACED AND WITNESSED 3/9/66

WITNESSES TO CORNER..... 18" W. Pine (1/2 S 9/10 NBT) N55°E, 16.0'

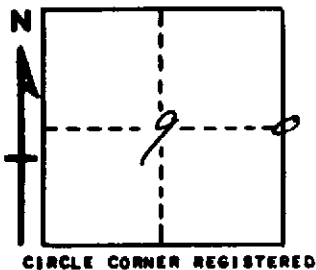

9" Hard Maple (1/2 S NBT) N35°W, 26.0'
(Birds Eye)

AND

DESCRIPTION IN DETAIL AS TO HOW CORNER WAS LOCATED AND IDENTIFIED OR RESTORED.

This corner replaced at wood post set by Northern Paper Mills. Corner lies midway between two Sec. Cors. Found no evidence of original witnesses.

Cor. lies on side hill sloping to west.

SURVEYOR'S SEAL

SIGNED Billy D. Buckler DATE 2/8/67
REGISTERED LAND SURVEYOR