

MICHIGAN
DEPARTMENT OF CONSERVATION
FORESTRY DIVISION

LAND CORNER RECORD

T. 47 N.R. 34W


Baraga COUNTY

DESCRIPTION OF CORNER Sec. Cor. common to Secs. 16-17-20-21

CORNER MONUMENT 1" pipe with 4" aluminum cap.

DATE MONUMENT PLACED AND WITNESSED 3/8/66

WITNESSES TO CORNER..... 9" Cedar (S21 NBT) East 32.3'

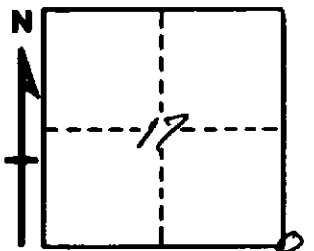

9" Cedar (S17 NBT) N70°W, 19.2'

AND

CIRCLE CORNER REGISTERED

DESCRIPTION IN DETAIL AS TO HOW CORNER WAS LOCATED AND IDENTIFIED OR RESTORED.

Replaced at old wood post. Found no evidence of the original bearing trees but did find two unrecorded witnesses over 100 years old.

20" Y. Birch S88°W, 17.8'
13" Cedar S50°E, 17.5'

Numerous registered signature on nearby trees.

SURVEYOR'S SEAL

SIGNED Billy D. Buckler DATE 2/8/67
REGISTERED LAND SURVEYOR