

MICHIGAN  
DEPARTMENT OF CONSERVATION  
FORESTRY DIVISION

LAND CORNER RECORD

T. 47 N.R. 34W


Baraga COUNTY

DESCRIPTION OF CORNER Sec. cor. common to secs. 8-9-16-17

CORNER MONUMENT 1" pipe with 4" aluminum cap

DATE MONUMENT PLACED AND WITNESSED 3/8/66

WITNESSES TO CORNER..... 20" W. Pine (NB NBT) N62°W, 59.8'

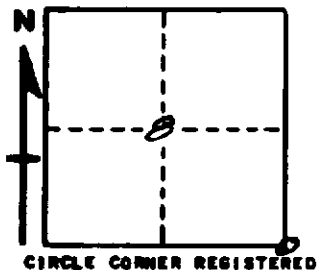

14" Soft Maple (S16 NBT) S40°E, 21.4'

AND

DESCRIPTION IN DETAIL AS TO HOW CORNER WAS LOCATED AND IDENTIFIED OR RESTORED.

This corner replaced at wood post set by unknown persons.  
Found several old blazes facing corner location.

SURVEYOR'S SEAL

SIGNED Billy D. Buckler DATE 2/8/67  
REGISTERED LAND SURVEYOR