

MICHIGAN
DEPARTMENT OF CONSERVATION
FORESTRY DIVISION

LAND CORNER RECORD

T. 47 N.R. 34W


Baraga COUNTY

DESCRIPTION OF CORNER Sec. cor. common to secs. 10-11-14-15

CORNER MONUMENT 1" Pipe with 4" Aluminum Cap.

DATE MONUMENT PLACED AND WITNESSED 3/15/66

WITNESSES TO CORNER..... 12" Cedar (N15 NBT) S40°W, 31.0'

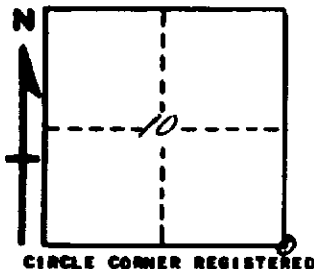

9" Cedar N52°W, 34.4'

AND

DESCRIPTION IN DETAIL AS TO HOW CORNER WAS LOCATED AND IDENTIFIED OR RESTORED.

Replaced corner at an old cedar post with blazes on a cedar facing the corner. Found a down cedar bearing N21 E, 28 Links but could find no identifying marks because of the ice and snow. Found line of blazes to west and south.

SURVEYOR'S SEAL

SIGNED Billy D. Buckler DATE 2/8/67
REGISTERED LAND SURVEYOR