

MICHIGAN
DEPARTMENT OF CONSERVATION
FORESTRY DIVISION

LAND CORNER RECORD

T. 47 N.R. 34W


Baraga COUNTY

DESCRIPTION OF CORNER Sec. Cor. common to Secs. 9-10-15-16

CORNER MONUMENT 1" pipe with 4" aluminum cap.

DATE MONUMENT PLACED AND WITNESSED 3/9/66

WITNESSES TO CORNER..... 12" Hard Maple (S 15 NBT) S75°E, 20.5'

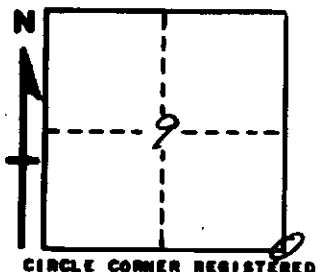

10" Y. Birch (S 16 NBT) S50°W, 27.5'

AND

DESCRIPTION IN DETAIL AS TO HOW CORNER WAS LOCATED AND IDENTIFIED OR RESTORED.

This corner placed at intersection of old blazed lines to north, south, east and west. Found wood post at corner. No other evidence.

SURVEYOR'S SEAL

SIGNED Billy D. Buckler DATE 2/8/67
REGISTERED LAND SURVEYOR