

LAND CORNER RECORDATION CERTIFICATE
Filing Requirement of Act 74, Mich. P.A. 1970

For corners in
Baraga
 (County)

	Located in:	Corner Code #/1
1. Public Land Survey	T <u>47N</u> R <u>34W</u>	<u>L2</u>
	T _____ R _____	_____
	T _____ R _____	_____
	T _____ R _____	_____
2. Property Controlling in Section	S <u>1</u> T <u>47N</u> R <u>34W</u>	<u>7</u>
	S <u>1</u> T <u>47N</u> R <u>34W</u>	<u>9</u>
3. Miscellaneous Property in Sec.	S _____ T _____ R _____	_____
	S _____ T _____ R _____	_____

Register of Deeds Stamp & File Number

4. Lot No. _____, Recorded Plat _____
 5. Private Claims _____

	A	B	C	D	E	F	G	H	I	J	K	L	M
2	1	2	3	4	5	6	7	8	9	10	11	12	13
3													
4	7	8	9	10	11	12	13	14	15	16	17	18	19
5													
6	15	16	17	18	19	20	21	22	23	24	25	26	27
7													
8	19	20	21	22	23	24	25	26	27	28	29	30	31
9													
10	29	30	31	32	33	34	35	36	37	38	39	40	41
11													
12	31	32	33	34	35	36	37	38	39	40	41	42	43
13													

I, Stephan J. Szyszkoski, in a field survey on July 26, 1994, 19_____, do hereby certify that under requirements of P.A. 74, Michigan P.A. of 1970, the corner points mentioned in lines 1 and 2 above were in conformance with regulations and rules therefore as required in the current manual of survey instructions of the United States Department of the Interior, Bureau of Land Management or by a decree of a Court of Law and/or that the corner points mentioned in lines 3, 4 and 5 above were in conformance with the rules of the Michigan Board of Land Surveyors or by a Decree of a Court of Law, established, re-established, monumented, re-monumented, recovered, found as expressed below:

NOTE: Not more than 4 corners, all in the same town and range, may be recorded on this certificate.

A. Description of original monument and accessories and/or subsequent restoration:

- (L2) Center of Section 1. Corner not established in the original survey. Found no subsequent record.
 (7-Sec. 1) North 1/16 corner between Section 1 T47N-R34W and Section 6 T47N-R33W. Corner not established in the original survey. Found no subsequent record.
 (9-Sec. 1) East 1/16 corner Section 1. Corner not established in the original survey. Found no subsequent record.

B. Description of corner evidence found and/or method applied in restoring or reestablishing corner:

- (L2) Established the corner at the intersection of straight lines connecting opposite 1/4 corners, all monumented. Found a 1" iron pipe projecting about 4 ft. and capped with a Wisconsin-Michigan Power Co. cap, N50W 62.74' from the corner. At the position for the corner, I placed a 1" I.D. x 32" iron pipe capped with a 4" dia. cast aluminum MDNR tablet, appropriately stamped.
 (7-Sec. 1) Found no evidence of prior monumentation at the corner position. Established the corner on a straight line between 1/4 corner 1308.87' south and township corner 1305.59' north, being 20 chains, proportionate to the original record, north of the 1/4 corner. At the position for the corner I placed a 1" I.D. x 32" iron pipe capped with a 4" dia. cast aluminum MDNR tablet, appropriately stamped. N-S cut traverse line is 8' west.
 (9-Sec. 1) Found no evidence of prior monumentation. Established the corner midway and on a straight line between quarter corner 1320.15' east and Center of section 1320.15' west. At the position for the corner, I placed a 1" I.D. x 32" iron pipe capped with a 4" dia. cast aluminum MDNR tablet, appropriately stamped.

C. Description of monument for corner and accessories established to perpetuate locating the position of the corner:

- | | | |
|---|--|--|
| (L2) Set a 1" pipe with a 4" MDNR cap.
Blazed and scribed the following bearing trees:
8" Sugar N42W 21.4' "1/4S BT"
7" Sugar N57E 9.4' "1/4S BT"
6" Sugar S29W 9.8' "1/4S BT"
5" Sugar S51E 34.8' "1/4S BT"
Placed a 3" squared sugar post adjacent.
Bearings are magnetic. Decl 2.5 deg W. | (7) Set a 1" pipe with 4" MDNR cap.
Blazed and scribed the following bearing trees:
10" Cedar N50W 33.1' "1/16S BT"
12" Maple N19E 14.2' "1/16S BT"
7" Maple S65E 12.4' "1/16S BT"
10" Maple S55W 11.3' "1/16S BT"
Squared a 6" Balsam S50E 1.6'
Bearings are magnetic. Decl 2.5 deg W. | (9) Set 1" iron pipe with 4" MDNR cap.
Blazed and scribed the following bearing trees:
10" Cedar N32W 14.4' "1/16S BT"
11" Cedar S20W 40.3' "1/16S BT"
18" Hawthorn S45E 11.0' "1/16S BT"
10" Cedar N32E 33.8' "1/16S BT"
Bearings are magnetic. Decl 2.5 deg W. |
|---|--|--|

Signed by

Stephan J. Szyszkoski


Date

8-16-94

Surveyor's Michigan License No.

33986

For the Michigan Department of Natural Resources - Forest Management Division

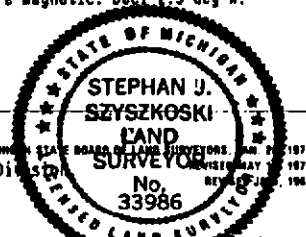

FORM APPROVED BY MICHIGAN BOARD OF LAND SURVEYORS MAY 1971
 REVISED MAY 1978
 REVISED MAY 1983