LAND CORNER RECORDATION CERTIFICATE
Filing Requirement of Act 74, Mich. P.A. 1970 as Amended

For corners in

Baraga (County)

		Located In:	Corner Code #
1. Public Land Survey		T 47N R 34W	F1
		T___ R___	
		T___ R___	
	S___	T___ R___	
2. Property Controlling	S___	T___ R___	
in Section	S___	T___ R___	
3. Miscellaneous	S___	T___ R___	
Property in Sec.	S___	T___ R___	

Register of Deeds Stamp & File Number

4. Lot No. _____ , Recorded Plat_____

5. Private Claims

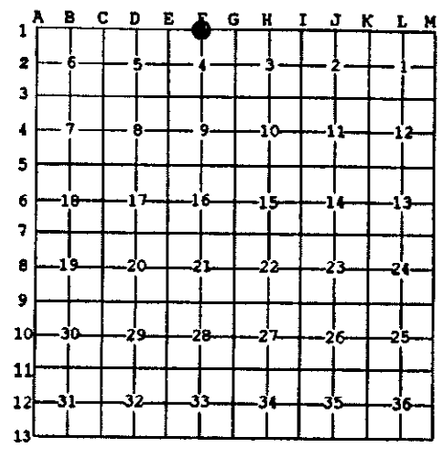

I, Stephan J. Szyszkoski, in a field survey on May 20 2004, 20 ____ do hereby state that under requirements of P.A. 74, Michigan P.A. of 1970, the corner points mentioned in lines 1 and 2 above were in conformance with regulations and rules therefore as required in the current manual of survey instructions of the United States Department of the Interior, Bureau of Land Management or by a decree of a Court of Law and /or that the corner points mentioned in lines 3, 4 and 5 above were in conformance with the rules of the Michigan Board of Land Surveyors or by a Decree of a Court of Law; established, re-established, monumented, recovered, found as expressed below:

NOTE: Not more than 2 corners, all in the same town and range, may be recorded on this certificate.

A. Description of original monument and accessories and/or subsequent restoration:

(F1) Quarter corner common to Section 4 T47N-R34W and Section 33 T48N-R34W. 1965: Frank J. Bray, RLS, remonumented the corner in the original position from two Tamarack BTs. Set 1" iron pipe with 4" aluminum cap. NBTs: 8" B.Spruce N41W 09 links, 6" B.Spruce S18E 25 links.

B. Description of corner evidence found and/or method applied in restoring or reestablishing corner:

(F1) Recovered the 1965 monument in good condition and at record bearing and distance from the 1965 NBTs. The B.Spruce NW is in good condition with overgrown blazes and the B.Spruce SE is a stump. Left the monument in place and made new witnesses as described below.

C. Description of monument for corner and accessories established to perpetuate locating the position of the corner:

(F1) Found 1"ID Iron pipe with 4" alum. MI Dept. of Conservation cap. Blazed, scribed and set meas. nails in:
6" B.Spruce N76E 9.8' "1/4S NBT"
8" B.Spruce S47E 24.3' do
7" B.Spruce S65W 17.1' do
8" B.Spruce N36W 6.2' overgrown blazes*
Bearings are magnetic. Distances are to nail with tag. *denotes 1965 NBT, no new marks made.

STATE OF MICHIGAN
STEPHAN J. SZYSZKOSKI
LAND SURVEYOR
No. 33986
LICENSED LAND SURVEYOR

Signed by Stephan J. Szyszkoski Date 7/1/04

Surveyor's Michigan License No. 33986

For the Michigan Department of Natural Resources, Office of Land and Facilities

FORM APPROVED BY MICHIGAN STATE BOARD OF PROFESSIONAL SURVEYORS, JAN. 28, 1971
Revised May 14, 1975
Revised Jan., 1983
Revised Oct., 1995