

LAND CORNER RECORDATION CERTIFICATE
Filing Requirement of Act 74, Mich. P.A. 1970 as Amended

For corners in

<u>Baraga</u> (County)	Located In:	Corner Code #
1. Public Land Survey	T <u>47N</u> R <u>34W</u>	<u>C4</u>
	T <u>47N</u> R <u>34W</u>	<u>E1</u>
	T _____ R _____	_____
2. Property Controlling in Section	S _____ T _____ R _____	_____
	S _____ T _____ R _____	_____
3. Miscellaneous Property in Sec.	S _____ T _____ R _____	_____
	S _____ T _____ R _____	_____

4. Lot No. _____, Recorded Plat _____
 5. Private Claims

E1 May 20 2004
 C4 May 19 2004

I, Stephan J. Szyszkoski, in a field survey on _____, 20____ do hereby state that under requirements of P.A. 74, Michigan P.A. of 1970, the corner points mentioned in lines 1 and 2 above were in conformance with regulations and rules therefore as required in the current manual of survey instructions of the United States Department of the Interior, Bureau of Land Management or by a decree of a Court of Law and /or that the corner points mentioned in lines 3, 4 and 5 above were in conformance with the rules of the Michigan Board of Land Surveyors or by a Decree of a Court of Law; established, re-established, monumented, recovered, found as expressed below:

NOTE: Not more than 2 corners, all in the same town and range, may be recorded on this certificate.

A. Description of original monument and accessories and/or subsequent restoration:


(C4) Quarter corner common to Sections 7-8. Established in 1852 by Z.B.Searles: [South] "corrected Btwn Secs 7&8...40.00 Set Quarter Section post. Sugar 18 S22E 12 links, Sugar 24 N85W-13 links. ... 80.00 Set post corner of Sections 7-8-17-18.
 (E1) Corner common to Sections 4-5 T47N-R34W and 32-33 T48N-R34W. Reestablished in 1965 by F.J.Bray, RLS, by single proportionate measurement between original Quarter corners east and west. 1" Iron pipe with 4" aluminum cap. NBTs: 18" W.Pine N74W 26.5 links, 7" B.Spruce S70E 29 links.

B. Description of corner evidence found and/or method applied in restoring or reestablishing corner:

(C4) The original post and accessories were not recovered. Reestablished the corner midway and on line between Section corners 2637.13' north and south, the position also being in the center of the Ford Road.
 (E1) Recovered the 1965 monument in good condition and at record bearing and distance from the W.Pine NBT. The B.Spruce NBT has been destroyed by road construction. Made the monument firm in a mound of rock and made new witnesses as described below.

C. Description of monument for corner and accessories established to perpetuate locating the position of the corner:

(C4) Set 1"IDx32" I.pipe with 4" alum. MDNR cap. Blazed, scribed, and set measuring nails in: 10" Y.Birch N59E 19.5' "1/4S NBT" 8" Y.Birch S76E 17.0' do 5" Sugar N86W 23.8' do 5" Sugar N17W 40.7' do Bearings are magnetic. Distances are to nail with tag. Drove the monument to 6" below the gravel surface.	(E1) Found 1" I.pipe with 4" alum. MI Dept. of Conservation cap. Blazed, scribed, and set measuring nails in: 27" W.Pine N68W 18.4' old blazes * 15" W.Pine N11W 39.2' "S32 NBT" 3" Sugar N19E 19.4' "S33 NBT" 18" W.Pine S43E 58.6' "S4 NBT" Set sq'd cedar post adjacent. Bearings are magnetic. Distances are to nail with tag. * denotes 1965 NBT no new marks.
---	---

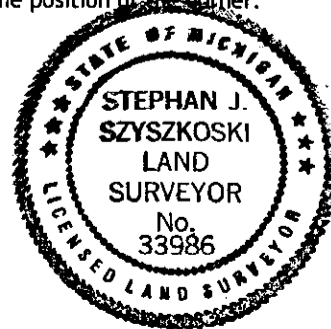

Signed by Stephan J. Szyszkoski
 Surveyor's Michigan License No. 33986

Date 7/1/04

For the Michigan Department of Natural Resources, Office of Land and Facilities

