

LAND CORNER RECORDATION CERTIFICATE
Filing Requirement of Act 74, Mich. P.A. 1970 as Amended

For corners in

<u>Baraga</u> (County)	Located In:	Corner Code #
1. Public Land Survey	T 47N R 34W	M6
	T _____ R _____	_____
	T _____ R _____	_____
2. Property Controlling in Section	S T _____ R _____	_____
	S 13 T 47N R 34W	2
	S _____ T _____ R _____	_____
3. Miscellaneous Property in Sec.	S _____ T _____ R _____	_____
	S _____ T _____ R _____	_____
4. Lot No. _____, Recorded Plat _____		
5. Private Claims		

Register of Deeds Stamp & File Number

	A	B	C	D	E	F	G	H	I	J	K	L	M
1													
2	6		5		4		3		2		1		
3													
4	7		8		9		10		11		12		
5													
6	18		17		16		15		14		13		
7													
8	19		20		21		22		23		24		
9													
10	30		29		28		27		26		25		
11													
12	31		32		33		34		35		36		
13													

I, Stephan J. Szyszkoski, in a field survey on 2 08/24/2009 do hereby state that under requirements of P.A. 74, Michigan P.A. of 1970, the corner points mentioned in lines 1 and 2 above were in conformance with regulations and rules therefore as required in the current manual of survey instructions of the United States Department of the Interior, Bureau of Land Management or by a decree of a Court of Law and /or that the corner points mentioned in lines 3, 4 and 5 above were in conformance with the rules of the Michigan Board of Land Surveyors or by a Decree of a Court of Law; established, re-established, monumented, recovered, found as expressed below:

NOTE: Not more than 2 corners, all in the same town and range, may be recorded on this certificate.

A. Description of original monument and accessories and/or subsequent restoration:

(M6) Quarter corner common to Section 13 T47N-R34W and Section 18 T47N-R33W. 1846 - Established by Austin Burt Deputy Surveyor midway and on the Range line between Section corners 40.00 chains north and south. Set Spruce post. Spruce 6" S28E 66 links, Tamarack 6" N77W 82 links.

(2-Sec. 13) East 1/16 corner between Sections 12 and 13. Not established in the original survey.

B. Description of corner evidence found and/or method applied in restoring or reestablishing corner:

(M6) The original post and accessories were not recovered. Found no evidence of the position of the original corner on the ground. Reestablished the corner midway and on the Range line between Section corners 2612.61' north and south.

(2-Sec. 13) Established the corner midway and on the Section line between Quarter corner 1314.54' west and Section corner 1314.54' east.


C. Description of monument for corner and accessories established to perpetuate locating the position of the corner:

(M6) Set 1"IDx32" I.pipe with 4" alum. MDNR cap. Set measuring nail with MDNR tag in the side of:
 3" Tamarack S50E 63.6' mrkd "1/4S NBT"
 2" Tamarack S13W 46.9' do
 3" Tamarack N70W 54.8' do
 2" Tamarack N21W 47.2' do
 Set sq'd Cedar post adjacent.
 Bearings are magnetic.

(2) Set 1"IDx32" I.pipe with 4" alum. MDNR cap. Set measuring nail with MDNR tag in the side of:
 4" Poplar S74E 20.4' mrkd "1/16S BT"
 4" Poplar S33E 8.9' do
 3" Maple N67W 11.2' do
 3" Maple N23W 8.85' do
 Set sq'd Cedar post adjacent.
 Bearings are magnetic.

Signed by Stephan J. Szyszkoski
 Surveyor's Michigan License No. 33986

Date 09/22/2009

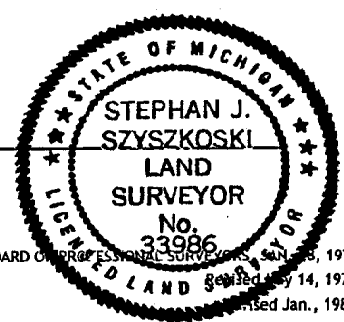

For the Michigan Department of Natural Resources, Office of Land and Facilities

16300
16304