


**LAND CORNER RECORDATION CERTIFICATE**  
**Filing Requirement of Act 74, Mich. P.A. 1970 as Amended**

For corners in

Baraga	Located In:	Corner Code #
(County)		
1. Public Land Survey	T _____ R _____	_____
	T _____ R _____	_____
	T _____ R _____	_____
2. Property Controlling in Section	S <u>4</u> T <u>47N</u> R <u>34W</u>	<u>9</u>
	S <u>4</u> T <u>47N</u> R <u>34W</u>	<u>16</u>
	S _____ T _____ R _____	_____
3. Miscellaneous Property in Sec.	S _____ T _____ R _____	_____
	S _____ T _____ R _____	_____
4. Lot No. _____, Recorded Plat _____		
5. Private Claims		

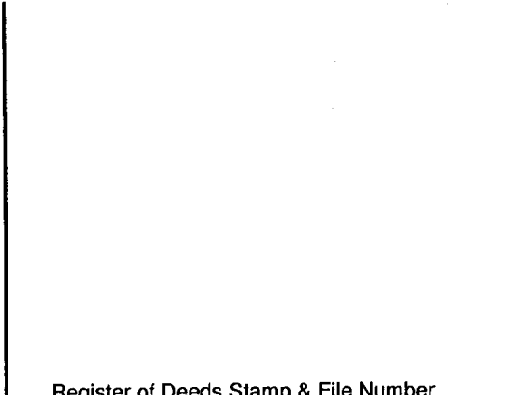

Register of Deeds Stamp & File Number

	A	B	C	D	E	F	G	H	I	J	K	L	M
1													
2	6			5			4		3		2		1
3													
4	7			8			9		10		11		12
5													
6	18			17			16		15		14		13
7													
8	19			20			21		22		23		24
9													
10	30			29			28		27		26		25
11													
12	31			32			33		34		35		36
13													

I, Stephan J. Szyszkoski, in a field survey on 9 10/27/2008 do hereby state that under requirements of P.A. 74, Michigan P.A. of 1970, the corner points mentioned in lines 1 and 2 above were in conformance with regulations and rules therefore as required in the current manual of survey instructions of the United States Department of the Interior, Bureau of Land Management or by a decree of a Court of Law and /or that the corner points mentioned in lines 3, 4 and 5 above were in conformance with the rules of the Michigan Board of Land Surveyors or by a Decree of a Court of Law; established, re-established, monumented, recovered, found as expressed below:

**NOTE: Not more than 2 corners, all in the same town and range, may be recorded on this certificate.**

**A. Description of original monument and accessories and/or subsequent restoration:**

(9-Sec. 4) East 1/16 corner, Section 4. Not established in the original survey.

(16-Sec. 4) East 1/16 corner between Sections 4 and 9. 1974 - Established by A.O. Enger RLS midway and on line between Section corner 20.285 ch. east and Quarter corner 20.285 ch. west.

**B. Description of corner evidence found and/or method applied in restoring or reestablishing corner:**

(9-Sec. 4) Established the corner midway and on a straight line between Center of Section 1328.12' west and Quarter corner 1328.12' east. From the position thus established, I found a 3/4" iron pipe, not of record, S44E 18.2' distant, which I did not accept as marking the position for the corner. Removed the 3/4" iron pipe and placed it adjacent to the corner monument.

(16-Sec. 4) Recovered the 1974 monument in good condition and at record bearing and distance from the accessories of record. Found the monument to be S44E 36.2' from the proper corner position and did not accept the monument as marking the position for the corner. Established the corner midway and on the Section line between Quarter corner 1329.65' west and Section corner 1329.65' east. The 1974 survey appears to suffer from at least two measurement errors made in the traverse between Section corners E3 and G3. Removed the 1974 monument.

**C. Description of monument for corner and accessories established to perpetuate locating the position of the corner:**

(9) Set 1"IDx32" I.pipe with 4" alum. MDNR cap made firm in a mound of rock. Set measuring nail with MDNR tag in the side of:  
 5" Sugar N84E 13.0' mrkd "1/16S BT"  
 15" Y.Birch S36W 31.6' do  
 10" Sugar N68W 15.8' do  
 4" Sugar N02W 8.05' do  
 Set sq'd cedar post adjacent.  
 Bearings are magnetic.

(16) Set 1"IDx32" I.pipe with 4" alum. MDNR cap made firm in a mound of rock. Set measuring nail with MDNR tag in the side of:  
 27" W.Pine S82E 22.0' mrkd "1/16S BT"  
 8" Tamarack S23W 28.6' do  
 20" W.Pine N13W 24.4' do  
 19" W.Pine N25E 32.45' do  
 Set sq'd cedar post S30W 2.8'  
 Bearings are magnetic.

Signed by Stephan J. Szyszkoski  
 Surveyor's Michigan License No. 33986

Date 11/03/2008

For the Michigan Department of Natural Resources, Office of Land and Facilities

