LAND CORNER RECORDATION CERTIFICATE

Filing Requirement of Act 74, Mich. P.A. 1970 as Amended

For corners in

Baraga (County) Located In: Corner Code #

1. Public Land Survey T 47N R 34W I3
   T R
   T R
2. Property Controlling S T R
   in Section S T R
   S T R
3. Miscellaneous S T R
   Property in Sec. S T R
4. Lot No. _____, Recorded Plat _____
5. Private Claims

Register of Deeds Stamp & File Number

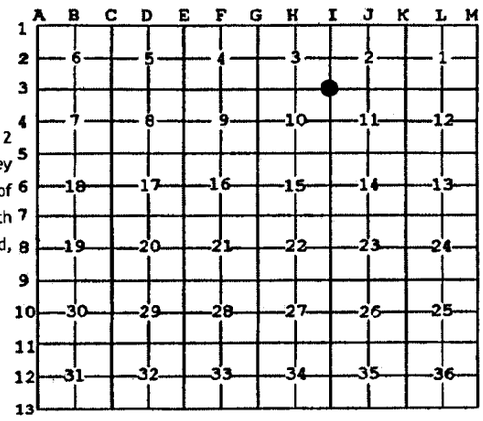

I, Stephan J. Szyszkoski, in a field survey on 10/28/2008 do hereby state that under requirements of P.A. 74, Michigan P.A. of 1970, the corner points mentioned in lines 1 and 2 above were in conformance with regulations and rules therefore as required in the current manual of survey instructions of the United States Department of the Interior, Bureau of Land Management or by a decree of a Court of Law and /or that the corner points mentioned in lines 3, 4 and 5 above were in conformance with the rules of the Michigan Board of Land Surveyors or by a Decree of a Court of Law; established, re-established, monumented, recovered, found as expressed below:

NOTE: Not more than 2 corners, all in the same town and range, may be recorded on this certificate.

A. Description of original monument and accessories and/or subsequent restoration:

(I3) Corner common to Sections 2-3-10-11. 1852 - Established by Z.B.Searles Deputy Surveyor. Set post. Spruce 16" S44W 26 links, Cedar 10" N09E 18 links. The original record gives distances 40.00 ch. north to Quarter corner, 40.20 ch. east to Quarter corner, 80.00 ch. south to Section corner, 79.84 ch. west to Section corner.

B. Description of corner evidence found and/or method applied in restoring or reestablishing corner:

(I3) The original post and accessories were not recovered. Found no evidence of the position of the original corner on the ground. Reestablished the corner by double proportionate measurement to the original record between Quarter corner 2628.43' north, Quarter corner 2648.21' east, Section corner 5257.65' south, and Section corner 5259.48' west.

C. Description of monument for corner and accessories established to perpetuate locating the position of the corner:

(I3) Set 1"IDx32" I.pipe with 4" alum. MDNR cap.
Set measuring nail with MDNR tag in the side of:
4" Sugar N80E 18.6' mrkd "S2 NBT"
9" Sugar S27E 4.2' "S11 NBT"
8" Maple S88W 16.8' "S10 NBT"
5" Sugar N34W 15.45' "S3 NBT"
Set sq'd cedar post adjacent.
Bearings are magnetic.

STATE OF MICHIGAN
STEPHAN J. SZYSZKOSKI
LAND SURVEYOR
No. 33986
LICENSED LAND SURVEYOR

Signed by Stephan J. Szyszkoski Date 11/03/2008

Surveyor's Michigan License No. 33986

For the Michigan Department of Natural Resources, Office of Land and Facilities

FORM APPROVED BY MICHIGAN STATE BOARD OF PROFESSIONAL SURVEYORS, JAN. 28, 1971
Revised May 14, 1975
Revised Jan., 1983
Revised Oct., 1995

16187