LAND CORNER RECORDATION CERTIFICATE

Filing Requirement of Act 74, Mich. P.A. 1970 as Amended

For corners in

Baraga (County) Located In: Corner Code #

1. Public Land Survey		T 47N	R 34W	F3
		T	R	
		T	R	
2. Property Controlling	S	T	R	
in Section	S	T	R	
	S	T	R	
3. Miscellaneous	S	T	R	
Property in Sec.	S	T	R	

4. Lot No. _____, Recorded Plat _____

5. Private Claims

Register of Deeds Stamp & File Number

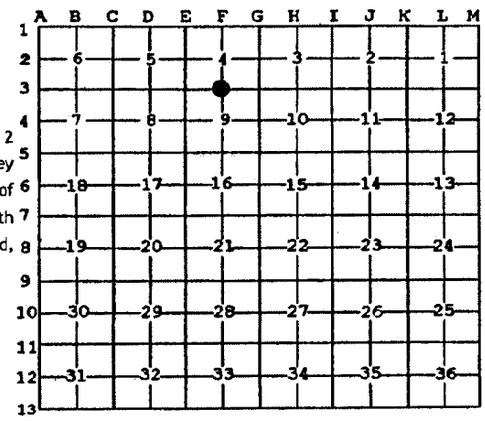

I, Stephan J. Szyszkoski, in a field survey on 10/28/2008 do hereby state that under requirements of P.A. 74, Michigan P.A. of 1970, the corner points mentioned in lines 1 and 2 above were in conformance with regulations and rules therefore as required in the current manual of survey instructions of the United States Department of the Interior, Bureau of Land Management or by a decree of a Court of Law and /or that the corner points mentioned in lines 3, 4 and 5 above were in conformance with the rules of the Michigan Board of Land Surveyors or by a Decree of a Court of Law; established, re-established, monumented, recovered, found as expressed below:

NOTE: Not more than 2 corners, all in the same town and range, may be recorded on this certificate.

A. Description of original monument and accessories and/or subsequent restoration:

(F3) Quarter corner common to Sections 4 and 9. 1852 - Established by Z.B.Searles Deputy Surveyor midway and on the Section line between Section corners 40.325 chains east and west. Set post. Tamarack 4" S58W 23 links, Spruce 4" N72E 12 links. 1974 - Reestablished by A.O.Enger RLS: "Found no evidence of original post or its accessories or of any replacement monuments or accessories. Re-established on line between Section corner 40.569 ch. to E and to W. Found a 3"x3"x4' squared post S73E 0.419 ch. set by unknown persons for an approximate corner. Set 1"IDx36" iron pipe with 3.5" aluminum cap. B.Spruce 4" N29E 18.1', B.Spruce 4" S41W 27.5'.

B. Description of corner evidence found and/or method applied in restoring or reestablishing corner:

(F3) Recovered the 1974 monument in good condition and at record bearing and distance from the 1974 accessories of record. Found the monument to be S43E 23.9' from the position intended to be reestablished in 1974, and I did not accept the monument as marking the position for the corner. Established the corner midway and on the Section line between Section corners 2659.30' east and west. The 1974 survey appears to suffer from at least two measurement errors made in the traverse between Section corners E3 and G3. Removed the 1974 monument.

C. Description of monument for corner and accessories established to perpetuate locating the position of the corner:

(F3) Set 1"IDx32" I.pipe with 4" alum. MDNR cap
made firm with large rocks and wooden hubs.
Set measuring nail with MDNR tag in the side of:
4" B.Spruce N06E 32.1' mrkd "1/4S NBT"
5" B.Spruce N53E 12.1' do
5" B.Spruce S68E 9.6' do
4" B.Spruce S81W 0.6' do
Set sq'd cedar post adjacent.
Bearings are magnetic.

STATE OF MICHIGAN
STEPHAN J. SZYSZKOSKI
LAND SURVEYOR
No. 33986
LICENSED LAND SURVEYOR

Signed by Stephan J. Szyszkoski Date 11/03/2008

Surveyor's Michigan License No. 33986

For the Michigan Department of Natural Resources, Office of Land and Facilities

FORM APPROVED BY MICHIGAN STATE BOARD OF PROFESSIONAL SURVEYORS, JAN. 28, 1971
Revised May 14, 1975
Revised Jan., 1983
Revised Oct., 1995

16184