

LAND CORNER RECORDATION CERTIFICATE
Filing Requirement of Act 74, Mich. P.A. 1970 as Amended

For corners in

<u>Baraga</u> <small>(County)</small>	Located In:	Corner Code #	
1. Public Land Survey	T 48N R 31W	A2	
	T 48N R 31W	B3	
2. Property Controlling in Section	S _____ T _____ R _____	_____	_____
	S _____ T _____ R _____	_____	_____
3. Miscellaneous Property in Sec.	S _____ T _____ R _____	_____	_____
	S _____ T _____ R _____	_____	_____
4. Lot No. _____, Recorded Plat _____			
5. Private Claims			

Register of Deeds Stamp & File Number

	A	B	C	D	E	F	G	H	I	J	K	L	M
1													
2	6	5	4	3	2	1							
3													
4	7	8	9	10	11	12							
5													
6	18	17	16	15	14	13							
7													
8	19	20	21	22	23	24							
9													
10	30	29	28	27	26	25							
11													
12	31	32	33	34	35	36							
13													

I, Stephan J. Szyszkoski, in a field survey on A2 11/10/2009 do hereby state that under requirements of P.A. 74, Michigan P.A. of 1970, the corner points mentioned in lines 1 and 2 above were in conformance with regulations and rules therefore as required in the current manual of survey instructions of the United States Department of the Interior, Bureau of Land Management or by a decree of a Court of Law and /or that the corner points mentioned in lines 3, 4 and 5 above were in conformance with the rules of the Michigan Board of Land Surveyors or by a Decree of a Court of Law; established, re-established, monumented, recovered, found as expressed below:

NOTE: Not more than 2 corners, all in the same town and range, may be recorded on this certificate.

A. Description of original monument and accessories and/or subsequent restoration:

(A2) Quarter corner common to Section 6 T48N-R31W and Section 1 T48N-R32W. 1845 - Established by John Burt, Deputy Surveyor on the Range line 40.00 chains north of Section corner and 38.98 chains south of Township corner. Set Sugar post. Y.Birch 18 N66E 20 links, Y.Birch 16 S80W 16 links. Found no subsequent record.

(B3) Quarter corner common to Sections 6 and 7. 1981 - Remonumented by Robert E. Schmeling RLS and described and recorded in Liber 4 of LCRC, Page 11, Baraga County Records. Set 1"IDx4' I.pipe with brass cap. Sugar 12" N34E 35.1', Sugar 8" S40E 8.5', Sugar 8" S48W 7.8', Sugar 16" N12W 41.7'. All trees have measuring nail at C/L and were scribed. Rocks piled around corner.

B. Description of corner evidence found and/or method applied in restoring or reestablishing corner:

(A2) The original post and accessories were not recovered. Found no evidence of the position of the original corner on the ground. Reestablished the corner on the Range line between Section corner 2620.95' south and Township corner 2554.11' north, being proportionate to the original record. From the position thus established I found a 1" steel pin, projecting 43" above ground, not of record, 119.6' south and 13.7' west, which I did not accept as marking the position of the corner.

(B3) Found the 1981 monument in good condition and at record bearing and distance from the 1981 accessories. All but the Sugar NBT NE are in good condition with scribing visible and clear overgrowth scars obscuring the measuring nails. The Sugar NE is a standing dead stub with scribing plain. Accepted the monument as a careful and faithful perpetuation of the position of the original corner.


C. Description of monument for corner and accessories established to perpetuate locating the position of the corner:

(A2) Set 1"IDx32" I.pipe with 4" alum. MDNR cap. Set measuring nail with MDNR tag in the side of:
 16" Y.Birch N03W 29.0' mrkd "1/4S NBT"
 5" Spruce N85E 8.5' do
 12" Maple S13W 13.2' do
 9" Spruce S45W 13.2' do
 Set sq'd cedar post adjacent.
 Bearings are magnetic.

(B3) Found 1"ID I.pipe with brass MEAD CORP cap. Set measuring nail with MDNR tag in the side of:
 5" Sugar N15E 14.3' mrkd "1/4S NBT"
 The 1981 NBTs were found: (dist. to nail scar)
 9" Sugar S33E 8.2' scribing visible
 9" Sugar S53W 7.8' do
 16" Sugar N04W 41.4' do
 Set sq'd cedar post adjacent. Brgs. magnetic.

Signed by Stephan J. Szyszkoski
 Surveyor's Michigan License No. 33986

Date 03/25/2010

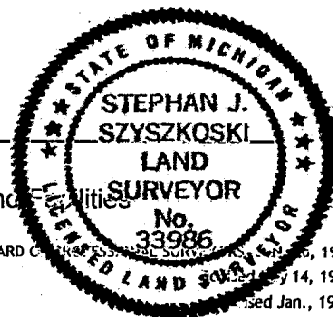

For the Michigan Department of Natural Resources and Environment, Office of Land and Water Resources