

**LAND CORNER RECORDATION CERTIFICATE**  
**Filing Requirement of Act 74, Mich. P.A. 1970 as Amended**

For corners in

Baraga	Located In:	Corner Code #
(County)		
1. Public Land Survey	T _____ R _____	_____
	T _____ R _____	_____
	T _____ R _____	_____
2. Property Controlling in Section	S 23 T 48N R 31W _____	J8
	S 23 T 48N R 31W _____	5
	S _____ T _____ R _____	_____
3. Miscellaneous Property in Sec.	S _____ T _____ R _____	_____
	S _____ T _____ R _____	_____

4. Lot No. \_\_\_\_\_, Recorded Plat \_\_\_\_\_  
 5. Private Claims \_\_\_\_\_

I, Stephan J. Szyszkoski, in a field survey on 5 11/19/2009 do hereby state that under requirements of P.A. 74, Michigan P.A. of 1970, the corner points mentioned in lines 1 and 2 above were in conformance with regulations and rules therefore as required in the current manual of survey instructions of the United States Department of the Interior, Bureau of Land Management or by a decree of a Court of Law and /or that the corner points mentioned in lines 3, 4 and 5 above were in conformance with the rules of the Michigan Board of Land Surveyors or by a Decree of a Court of Law; established, re-established, monumented, recovered, found as expressed below:

**NOTE: Not more than 2 corners, all in the same town and range, may be recorded on this certificate.**

**A. Description of original monument and accessories and/or subsequent restoration:**

(J8) Center of Section 23. Not established in the original survey.

(5-Sec. 23) North 1/16 corner, Section 23. Not established in the original survey.

**B. Description of corner evidence found and/or method applied in restoring or reestablishing corner:**

(J8) Established the corner at the intersection of straight lines connecting opposite 1/4 corners.

(5-Sec. 23) Established the corner midway and on a straight line between Quarter corner 1309.65' north and Center of Section 23 1309.65' south.

**C. Description of monument for corner and accessories established to perpetuate locating the position of the corner:**

(J8) Set 1"IDx32" I.pipe with 4" alum. MDNR cap. Set measuring nail with MDNR tag in the side of:  
 16" Oak N13E 19.9' mrkd "C1/4 BT"  
 5" Sugar N44E 15.3' do  
 5" twin Sugar S32E 24.05' do  
 7" Hemlock S80W 29.2' do  
 Set sq'd Cedar post adjacent.  
 Bearings are magnetic.


(5) Set 1"IDx32" I.pipe with 4" alum. MDNR cap. Set measuring nail with MDNR tag in the side of:  
 10" Cedar N05E 9.3' mrkd "1/16S BT"  
 9" Cedar S78E 27.1' do  
 8" Maple S56W 27.1' do  
 10" Maple N27W 7.7' do  
 Set sq'd Cedar post adjacent.  
 Bearings are magnetic.

Register of Deeds Stamp & File Number

	A	B	C	D	E	F	G	H	I	J	K	L	M
1													
2	6	5	4	3	2	1							
3													
4	7	8	9	10	11	12							
5													
6	18	17	16	15	14	13							
7													
8	19	20	21	22	23	24							
9													
10	30	29	28	27	26	25							
11													
12	31	32	33	34	35	36							
13													

Signed by Stephan J. Szyszkoski  
 Surveyor's Michigan License No. 33986

Date 03/25/2010

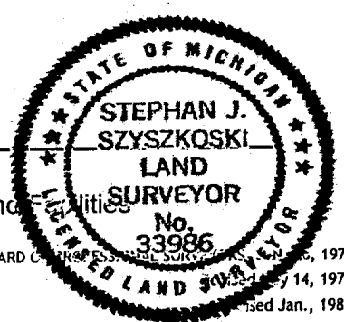

For the Michigan Department of Natural Resources and Environment, Office of Land and Water Management

16379  
 16380