

**LAND CORNER RECORDATION CERTIFICATE**  
**Filing Requirement of Act 74, Mich. P.A. 1970 as Amended**

For corners in

<u>Baraga</u> (County)	Located In:	Corner Code #
1. Public Land Survey	T 48N R 31W	G1
	T 48N R 31W	G3
2. Property Controlling in Section	T _____ R _____	_____
	S _____ T _____ R _____	_____
	S _____ T _____ R _____	_____
3. Miscellaneous Property in Sec.	S _____ T _____ R _____	_____
	S _____ T _____ R _____	_____
4. Lot No. _____, Recorded Plat _____		
5. Private Claims		

Register of Deeds Stamp & File Number

	A	B	C	D	E	F	G	H	I	J	K	L	M
1							●						
2	6		5		4		3		2			1	
3							●						
4	7		8		9		10		11			12	
5													
6	18		17		16		15		14			13	
7													
8	19		20		21		22		23			24	
9													
10	30		29		28		27		26			25	
11													
12	31		32		33		34		35			36	
13													

I, Stephan J. Szyszkoski, in a field survey on G1 04/21/2010 do hereby state that under requirements of P.A. 74, Michigan P.A. of 1970, the corner points mentioned in lines 1 and 2 above were in conformance with regulations and rules therefore as required in the current manual of survey instructions of the United States Department of the Interior, Bureau of Land Management or by a decree of a Court of Law and /or that the corner points mentioned in lines 3, 4 and 5 above were in conformance with the rules of the Michigan Board of Land Surveyors or by a Decree of a Court of Law; established, re-established, monumented, recovered, found as expressed below:

NOTE: Not more than 2 corners, all in the same town and range, may be recorded on this certificate.

A. Description of original monument and accessories and/or subsequent restoration:

(G1) Corner common to Sections 3-4 T48N-R31W and Sections 33-34 T49N-R31W. 1846 - Established by John Burt Deputy Surveyor on the Township line between Standard Section corners 80.00 chains east and west. Set Spruce post. Sugar 7 N55E 35 links, Cedar 16 N60W 17 links. Undated Mead Corp. corner map notes "post" at corner. No subsequent record found.

(G3) Corner common to Sections 3-4-9-10. 1848 - Established by Wells Burt Deputy Surveyor. Set Y.Birch post. Sugar 10 S24W 29 links, Fir 12 N60E 20 links.

B. Description of corner evidence found and/or method applied in restoring or reestablishing corner:

(G1) The original post and accessories were not recovered. Found a 1"ID iron pipe with mushroomed top, set firmly, projecting about 6" above ground, in good condition. Recovered Section corners of record 2 miles east and west at K1 and C1, respectively and determined that this pipe is approx. 11' West and approx. 11' North of the single proportionate position between them, based upon the original GLO record. I accepted the pipe as the best available evidence of the position of the original corner.

(G3) The original post and accessories were not recovered. Found no acceptable evidence of the position of the original corner on the ground. Reestablished the corner by double proportionate measurement to the original record between corners 119.131 chains west (119.84 GLO), 79.487 chains east (79.96 GLO), 79.165 chains north (79.95 GLO), and 79.215 chains south (80.00 GLO).


C. Description of monument for corner and accessories established to perpetuate locating the position of the corner:

(G1) Found 1"ID Iron pipe.  
 Set measuring nail with MDNR tag in the side of:  
 5" Sugar in clump N33E 23.15' mrkd "S34 NBT"  
 7" Spruce N70E 23.2' do  
 10" Spruce S44E 16.8' "S3 NBT"  
 14" W.Pine S54W 27.95' "S4 NBT"  
 Set Sq'd cedar post adjacent.  
 Bearings are magnetic.

(G3) Set 1"IDx32" I.pipe with 4" alum. MDNR cap.  
 Set measuring nail with MDNR tag in the side of:  
 11" Maple N37E 21.1' mrkd "S3 NBT"  
 4" Sugar S35E 10.85' "S10 NBT"  
 5" Sugar S58W 16.2' "S9 NBT"  
 7" Sugar N49W 7.6' "S4 NBT"  
 Set sq'd cedar post adjacent.  
 Bearings are magnetic.

Signed by Stephan J. Szyszkoski  
 Surveyor's Michigan License No. 33986

Date 07/07/2010

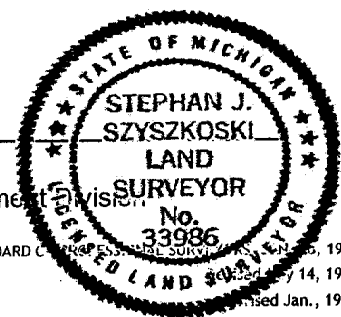

For the Michigan Department of Natural Resources and Environment, Forest Management Division